

1 LOCATION OF WATER WELL: Fraction NW 1/4 NE 1/4 NE 1/4 Section Number 32 Township Number T 19 S Range Number R 13 EW

County: Barton Distance and direction from nearest town or city street address of well if located within city?

2723 10th Street

2 WATER WELL OWNER: The Musket Corporation

RR#, St. Address, Box #: P.O. Box 26210


City, State, ZIP Code: Oklahoma City OK 63126

Board of Agriculture, Division of Water Resources

Application Number:

3 LOCATE WELL'S LOCATION WITH AN "X" IN SECTION BOX:

4 DEPTH OF COMPLETED WELL: 14 ft. ELEVATION: 8.5 ft.

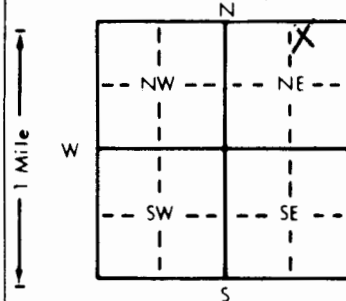

Depth(s) Groundwater Encountered 1 8.5 ft. 2 ft. 3 ft.

WELL'S STATIC WATER LEVEL 7.36 ft. below land surface measured on mo/day/yr 3-4-93

Pump test data: Well water was ft. after hours pumping gpm

Est. Yield gpm Well water was ft. after hours pumping gpm

Bore Hole Diameter 8 in. to ft. and in. to ft.

WELL WATER TO BE USED AS: 5 Public water supply 8 Air conditioning 11 Injection well

1 Domestic 3 Feedlot 6 Oil field water supply 9 Dewatering 12 Other (Specify below)

2 Irrigation 4 Industrial 7 Lawn and garden only 10 Monitoring well

Was a chemical/bacteriological sample submitted to Department? Yes No X If yes, mo/day/yr sample was submitted

Water Well Disinfected? Yes No X

5 TYPE OF BLANK CASING USED:

5 Wrought iron 8 Concrete tile CASING JOINTS: Glued Clamped

1 Steel 3 RMP (SR)

6 Asbestos-Cement 9 Other (specify below)

2 PVC 4 ABS

7 Fiberglass

Welded threaded Flush

Blank casing diameter 2 in. to ft. Dia in. to ft. Dia in. to ft.

Casing height above land surface Flush in. weight 703 lbs. ft. Wall thickness or gauge No. 154

TYPE OF SCREEN OR PERFORATION MATERIAL:

1 Steel 3 Stainless steel 5 Fiberglass 8 RMP (SR) 10 Asbestos-cement

2 Brass 4 Galvanized steel 6 Concrete tile 9 ABS 11 Other (specify)

12 None used (open hole)

SCREEN OR PERFORATION OPENINGS ARE:

1 Continuous slot 3 Mill slot 5 Gauzed wrapped 8 Saw cut 11 None (open hole)

2 Louvered shutter 4 Key punched 6 Wire wrapped 9 Drilled holes

7 Torch cut 10 Other (specify)

SCREEN-PERFORATED INTERVALS:

From 4 ft. to 14 ft. From ft. to ft.

From ft. to ft. From ft. to ft.

GRAVEL PACK INTERVALS:

From 3 ft. to 14 ft. From ft. to ft.

From ft. to ft. From ft. to ft.

6 GROUT MATERIAL:

1 Neat cement 2 Cement grout 3 Bentonite 4 Other

Grout Intervals: From 3 ft. to 1 ft. From ft. to ft. From ft. to ft.

What is the nearest source of possible contamination:

1 Septic tank 4 Lateral lines 7 Pit privy 10 Livestock pens 14 Abandoned water well

2 Sewer lines 5 Cess pool 8 Sewage lagoon 11 Fuel storage 15 Oil well/Gas well

3 Watertight sewer lines 6 Seepage pit 9 Feedyard 12 Fertilizer storage 16 Other (specify below)

13 Insecticide storage

Direction from well?

NW

How many feet? 110

FROM	TO	LITHOLOGIC LOG	FROM	TO	PLUGGING INTERVALS
0.0	6.0	Silty, sandy			
6.0	10.0	Sand, medium to coarse grain, well sorted			
10.0	14.0	Sand & gravel, poorly sorted			
Flush mount waiver granted 12-17-93 for Love's Country Store #42; RDHE 06005332 by Don Taylor					

7 CONTRACTOR'S OR LANDOWNER'S CERTIFICATION: This water well was (1) constructed (2) reconstructed, or (3) plugged under my jurisdiction and was completed on (mo/day/year) 3-4-93 and this record is true to the best of my knowledge and belief. Kansas

Water Well Contractor's License No. 531

This Water Well Record was completed on (mo/day/yr) 3-23-93

under the business name of GSI

by (signature)

Allison J. J. J.