


1 LOCATION OF WATER WELL: County: Barton Fraction: NW 1/4 NE 1/4 NE 1/4 Section Number: 32 Township Number: T 19 S Range Number: R 13

Distance and direction from nearest town or city street address of well if located within city? 2701 10th Street Teachers Insurance Annuity Assoc. 780 Third Ave New York NY 10017

2 WATER WELL OWNER: RR#, St. Address, Box #: City, State, ZIP Code: Board of Agriculture, Division of Water Resources Application Number:

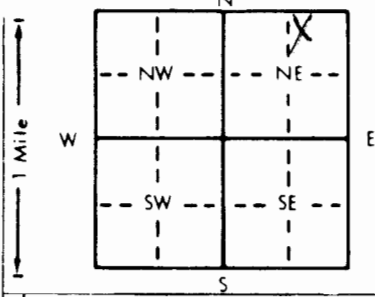

4 DEPTH OF COMPLETED WELL: 16 ft. ELEVATION: 2-26-93 ft. 3. Depth(s) Groundwater Encountered: 8.7 ft. 2. WELL'S STATIC WATER LEVEL: 8.7 ft. below land surface measured on mo/day/yr 2-26-93 Pump test data: Well water was ft. after hours pumping gpm Est. Yield gpm Well water was ft. after hours pumping gpm Bore Hole Diameter: 8 in. to ft. and in. to ft. WELL WATER TO BE USED AS: 5 Public water supply 8 Air conditioning 11 Injection well 1 Domestic 3 Feedlot 6 Oil field water supply 9 Dewatering 12 Other (Specify below) 2 Irrigation 4 Industrial 7 Lawn and garden only 10 Monitoring well Was a chemical/bacteriological sample submitted to Department? Yes No X If yes, mo/day/yr sample was submitted Water Well Disinfected? Yes No X

5 TYPE OF BLANK CASING USED: 1 Steel 3 RMP (SR) 5 Wrought iron 8 Concrete tile CASING JOINTS: Glued Clamped 2 PVC 4 ABS 6 Asbestos-Cement 9 Other (specify below) Welded Threaded 7 Fiberglass Blank casing diameter: 2 in. to ft. Dia. in. to ft. Dia. in. to ft. Casing height above land surface: Flush 0 in. weight: 70.3 lbs./ft. Wall thickness or gauge No. 154 TYPE OF SCREEN OR PERFORATION MATERIAL: 1 Steel 3 Stainless steel 5 Fiberglass 7 PVC 10 Asbestos-cement 2 Brass 4 Galvanized steel 6 Concrete tile 8 RMP (SR) 11 Other (specify) 12 None used (open hole) SCREEN OR PERFORATION OPENINGS ARE: 1 Continuous slot 3 Mill slot 5 Gauzed wrapped 8 Saw cut 11 None (open hole) 2 Louvered shutter 4 Key punched 6 Wire wrapped 9 Drilled holes 10 Other (specify) 7 Torch cut SCREEN-PERFORATED INTERVALS: From 6 ft. to 16 ft. From ft. to ft. From ft. to ft. GRAVEL PACK INTERVALS: From 5 ft. to 16 ft. From ft. to ft. From ft. to ft.

6 GROUT MATERIAL: 1 Neat cement 2 Cement grout 3 Bentonite 4 Other Grout Intervals: From 5 ft. to 1 ft. From ft. to ft. From ft. to ft. What is the nearest source of possible contamination: 1 Septic tank 4 Lateral lines 7 Pit privy 10 Livestock pens 14 Abandoned water well 2 Sewer lines 5 Cess pool 8 Sewage lagoon 11 Fuel storage 15 Oil well/Gas well 3 Watertight sewer lines 6 Seepage pit 9 Feedyard 12 Fertilizer storage 16 Other (specify below) 13 Insecticide storage Direction from well? W How many feet? 10

FROM	TO	LITHOLOGIC LOG	FROM	TO	PLUGGING INTERVALS
0.0	0.5	Concrete			
0.5	7.5	Clayey silt, dark brown			
7.5	8.0	Silty fine sand, orange			
8.0	10.0	Silty fine sand, gray			
10.0	16.0	Sand, medium to coarse Some gravel			
Flush mount waiver granted 3-24-93 for Bob's Fina; KDHE 06005508 by Don Taylor					

7 CONTRACTOR'S OR LANDOWNER'S CERTIFICATION: This water well was (1) constructed, (2) reconstructed, or (3) plugged under my jurisdiction and was completed on (mo/day/year) 3-25-93 and this record is true to the best of my knowledge and belief. Kansas Water Well Contractor's License No. 531 This Water Well Record was completed on (mo/day/yr) 3-26-93 under the business name of GSI by (signature) Allison J. Jura