


MW-3 201079

1 LOCATION OF WATER WELL: Fraction NW 1/4 NE 1/4 NE 1/4 Section Number 32 Township Number T 19 S Range Number R 74 EW 13
County: Barber Barton Distance and direction from nearest town or city street address of well if located within city?
2823 10th street

2 WATER WELL OWNER: Klepper Oil Co
RR#, St. Address, Box #: 2617 N Broadway
City, State, ZIP Code: Wichita KS 67219
Board of Agriculture, Division of Water Resources
Application Number:

3 LOCATE WELL'S LOCATION WITH AN "X" IN SECTION BOX:

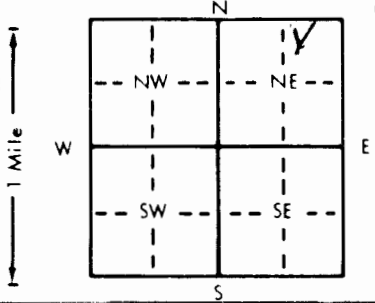

4 DEPTH OF COMPLETED WELL: 15 ft. ELEVATION: 9.5 ft.
Depth(s) Groundwater Encountered: 9.13 ft. 2 ft. 3 ft.
WELL'S STATIC WATER LEVEL: 9.13 ft. below land surface measured on mo/day/yr 3-18-93
Pump test data: Well water was ft. after hours pumping gpm
Est. Yield gpm Well water was ft. after hours pumping gpm
Bore Hole Diameter: 8 in. to ft. and in. to ft.
WELL WATER TO BE USED AS: 5 Public water supply 8 Air conditioning 11 Injection well
1 Domestic 3 Feedlot 6 Oil field water supply 9 Dewatering 12 Other (Specify below)
2 Irrigation 4 Industrial 7 Lawn and garden only 10 Monitoring well
Was a chemical/bacteriological sample submitted to Department? Yes No X If yes, mo/day/yr sample was submitted
Water Well Disinfected? Yes No X

5 TYPE OF BLANK CASING USED: 1 Steel 3 RMP (SR) 5 Wrought iron 8 Concrete tile CASING JOINTS: Glued Clamped
2 PVC 4 ABS 6 Asbestos-Cement 9 Other (specify below) Welded
Blank casing diameter 2 in. to ft. Dia in. to ft. Dia in. to ft.
Casing height above land surface: Flush in. weight 1703 lbs. ft. Wall thickness or gauge No. 154
TYPE OF SCREEN OR PERFORATION MATERIAL: 7 PVC 10 Asbestos-cement
1 Steel 3 Stainless steel 5 Fiberglass 8 RMP (SR) 11 Other (specify)
2 Brass 4 Galvanized steel 6 Concrete tile 9 ABS 12 None used (open hole)
SCREEN OR PERFORATION OPENINGS ARE: 5 Gauzed wrapped 8 Saw cut 11 None (open hole)
1 Continuous slot 3 Mill slot 6 Wire wrapped 9 Drilled holes
2 Louvered shutter 4 Key punched 7 Torch cut 10 Other (specify)
SCREEN-PERFORATED INTERVALS: From 5 ft. to 15 ft. From ft. to ft.
GRAVEL PACK INTERVALS: From 4 ft. to 15 ft. From ft. to ft.

6 GROUT MATERIAL: 1 Neat cement 2 Cement grout 3 Bentonite 4 Other
Grout Intervals: From 4 ft. to 1 ft. From ft. to ft. From ft. to ft.
What is the nearest source of possible contamination: 10 Livestock pens 14 Abandoned water well
1 Septic tank 4 Lateral lines 7 Pit privy 11 Fuel storage 15 Oil well/Gas well
2 Sewer lines 5 Cess pool 8 Sewage lagoon 12 Fertilizer storage 16 Other (specify below)
3 Watertight sewer lines 6 Seepage pit 9 Feedyard 13 Insecticide storage
Direction from well? N How many feet? 230

LITHOLOGIC LOG FROM TO PLUGGING INTERVALS
0.0 7.0 Silt, sandy
7.0 10.0 Silt, sandy
10.0 15.0 Sand, very coarse, poorly sorted
Flush mount waiver granted on 1-27-93
for Klepper Oil Co., KDHE 06005661
by Don Taylor

7 CONTRACTOR'S OR LANDOWNER'S CERTIFICATION: This water well was (1) constructed, (2) reconstructed, or (3) plugged under my jurisdiction and was completed on (mo/day/year) 3-18-93 and this record is true to the best of my knowledge and belief. Kansas
Water Well Contractor's License No. 531 This Water Well Record was completed on (mo/day/yr) 3-23-93
under the business name of GSI by (signature) Allison Irwin