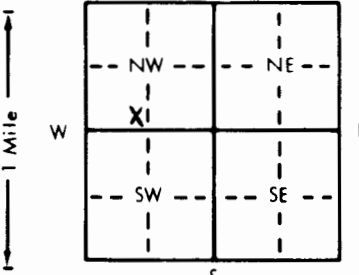


1 LOCATION OF WATER WELL:		Fraction	Section Number	Township Number	Range Number
County: Barton		SE 1/4 SW 1/4 NW 1/4	32	T 19 S	R 13 EW
Distance and direction from nearest town or city street address of well if located within city? 1/2 south of Great Bend					
2 WATER WELL OWNER: Matthews Construction					
RR#, St. Address, Box # :		Rt. 3		Board of Agriculture, Division of Water Resources	
City, State, ZIP Code :		Great Bend, Ks. 67530		Application Number: 36,338	
3 LOCATE WELL'S LOCATION WITH AN "X" IN SECTION BOX:		4 DEPTH OF COMPLETED WELL: 30 ft. ELEVATION:			
		Depth(s) Groundwater Encountered 1. ft. 2. ft. 3. ft.			
		WELL'S STATIC WATER LEVEL 9 ft. below land surface measured on mo/day/yr 1-24-83			
		Pump test data: Well water was ft. after hours pumping gpm			
		Est. Yield gpm: Well water was ft. after hours pumping gpm			
Bore Hole Diameter in. to ft., and in. to ft.		WELL WATER TO BE USED AS:			
1 Domestic		3 Feedlot	6 Oil field water supply	9 Dewatering	12 Other (Specify below)
2 Irrigation		4 Industrial	7 Lawn and garden only	10 Observation well	
Was a chemical/bacteriological sample submitted to Department? Yes..... No.....; If yes, mo/day/yr sample was submitted					
Water Well Disinfected? Yes No					
5 TYPE OF BLANK CASING USED:					
1 Steel		3 RMP (SR)	5 Wrought iron	8 Concrete tile	CASING JOINTS: Glued Clamped
2 PVC		4 ABS	6 Asbestos-Cement	9 Other (specify below)	Welded
			7 Fiberglass		Threaded
Blank casing diameter was 16 " in. to ft., Dia. in. to ft., Dia. in. to ft.					
Casing height above land surface in., weight lbs./ft. Wall thickness or gauge No.					
TYPE OF SCREEN OR PERFORATION MATERIAL:					
1 Steel		3 Stainless steel	5 Fiberglass	7 PVC	10 Asbestos-cement
2 Brass		4 Galvanized steel	6 Concrete tile	8 RMP (SR)	11 Other (specify)
				9 ABS	12 None used (open hole)
SCREEN OR PERFORATION OPENINGS ARE:					
1 Continuous slot		3 Mill slot	5 Gauzed wrapped	8 Saw cut	11 None (open hole)
2 Louvered shutter		4 Key punched	6 Wire wrapped	9 Drilled holes	
			7 Torch cut	10 Other (specify)	
SCREEN-PERFORATED INTERVALS: From ft. to ft. From ft. to ft.					
GRAVEL PACK INTERVALS: From ft. to ft. From ft. to ft.					
6 GROUT MATERIAL: 1 Neat cement 2 Cement grout 3 Bentonite 4 Other					
Grout Intervals: From ft. to ft. From ft. to ft. From ft. to ft.					
What is the nearest source of possible contamination:					
1 Septic tank		4 Lateral lines	7 Pit privy	10 Livestock pens	14 Abandoned water well
2 Sewer lines		5 Cess pool	8 Sewage lagoon	11 Fuel storage	15 Oil well/Gas well
3 Watertight sewer lines		6 Seepage pit	9 Feedyard	12 Fertilizer storage	16 Other (specify below)
				13 Insecticide storage	Sand pit
Direction from well?		east	How many feet? 1000'		
FROM	TO	LITHOLOGIC LOG	FROM	TO	LITHOLOGIC LOG
30	6	Gravel and sand			
6	3	Cement grout			
3	0	Top soil			
7 CONTRACTOR'S OR LANDOWNER'S CERTIFICATION: This water well was (1) constructed, (2) reconstructed, or (3) plugged under my jurisdiction and was completed on (mo/day/year) 2-8-83 and this record is true to the best of my knowledge and belief. Kansas					
Water Well Contractor's License No. 134		This Water Well Record was completed on (mo/day/yr) 4-15-83			
under the business name of Rosencrantz-Bemis Ent.		by (signature) <i>Aria Dodson</i>			
INSTRUCTIONS: Use typewriter or ball point pen, PLEASE PRESS FIRMLY and PRINT clearly. Please fill in blanks, underline or circle the correct answers. Send top three copies to Kansas Department of Health and Environment, Division of Environment, Environmental Geology Section, Topeka, KS 66620. Send one to WATER WELL OWNER and retain one for your records.					

OFFICE USE ONLY

T

R

13

EOD

SEC.

32

SE

5/11/14

4/11/14

DP