USE TYPEWRITER OR BALL POINT PEN-PRESS FIRMLY, PRINT CLEARLY.

WATER WELL RECORD
KSA 82a-1201-1215

Kansas Department of Health and Environment-Division of Environment
(Water well Contractors)
Topeka, Kansas 66620

1. Location of well:	County	Fraction	Section number	Township number	Range number
	Barton	se 1/4 se 1/4 ne 1/4	33	T 19 S	R 13 E/W

2. Distance and direction from nearest town or city:
2nd street in city of Great Bend, Ks.
Street address of well location if in city:

3. Owner of well: Dale Bodine
R.R. or street: 1531 Cherry Lane
City, state, zip code: Great Bend, Kansas 67530

4. Locate with "X" in section below:

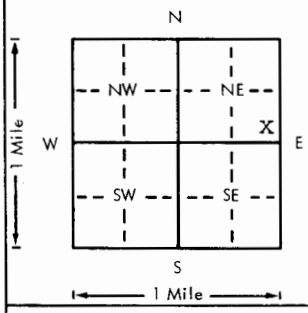

Sketch map:

6. Bore hole dia. 9 in. Completion date
Well depth 70 ft. 5-24-79

7. __ Cable tool X Rotary __ Driven __ Dug
__ Hollow rod __ Jetted __ Bored __ Reverse rotary

8. Use: __ Domestic __ Public supply __ Industry
__ Irrigation __ Air conditioning __ Stock
X Lawn __ Oil field water __ Other

9. Casing: Material pvc Height: Above or ~~below~~
Threaded __ Welded __ Surface 18 in.
RMP __ PVC X Weight __ lbs./ft.
Dia. 4" in. to 70 ft. depth Wall Thickness: inches or
Dia. __ in. to __ ft. depth gage No. .237

5. Type and color of material	From	To
topsoil	0	2
clay	2	5
sand & gravel	5	31
clay	31	53
sand & gravel	53	70

10. Screen: Manufacturer's name CertainTeed
Type pvc Dia.
Slot/~~gauge~~ 1/16 Length 20
Set between 70 ft. and 50 ft.
ft. and ft.
Gravel pack? X Size range of material 3/4 3/8

11. Static water level: mo./day/yr.
11 ft. below land surface Date 5-24-79

12. Pumping level below land surfaces: na
ft. after hrs. pumping g.p.m.
ft. after hrs. pumping g.p.m.
Estimated maximum yield g.p.m.

13. Water sample submitted: mo./day/yr.
X Yes __ No Date 5-24-79

14. Well head completion:
__ Pitless adapter Inches above grade

15. Well grouted? X
With: X Neat cement __ Bentonite __ Concrete
Depth: From 0 ft. to 10 ft.

16. Nearest source of possible contamination:
ft. 50 Direction North Type house septic
Well disinfected upon completion? X Yes __ No

17. Pump: X Not installed
Manufacturer's name
Model number HP Volts
Length of drop pipe ft. capacity g.p.m.
Type:
__ Submersible __ Turbine
__ Jet __ Reciprocating
__ Centrifugal __ Other

(Use a second sheet if needed)

18. Elevation:

Topography:
__ Hill
__ Slope
__ Upland
X Valley

19. Remarks:

20. Water well contractor's certification:
This well was drilled under my jurisdiction and this report is true to the best of my knowledge and belief.
Rosencrantz-Bemis 134
Business name License No.
Address Great Bend, Kansas 67530
Signed Sandy Kilgore Date 5-31-79
Authorized representative

T 19 S R 13 E/W Sec 33 1/4 1/4 1/4 1/4

Forward the white, blue and pink copies to the Department of Health and Environment

Form WWC-5