


1 LOCATION OF WATER WELL:		Fraction	Section Number	Township Number	Range Number
County:	Barton	SW ¼ SW ¼ SW ¼	33	T 19 S	R 13 E (W)

Rand & McArthur Great Bend

Board of Agriculture, Division of Water Resources
Application Number:

4 DEPTH OF COMPLETED WELL... 25 ft. ELEVATION: UNknown

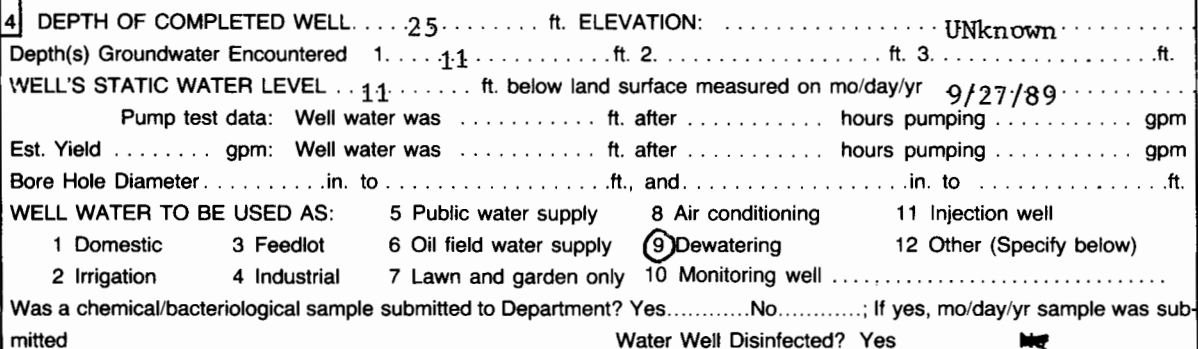

5 TYPE OF BLANK CASING USED:		3 Wrought iron		8 Concrete tile		CASING JOINTS: Glued Clamped	
1 Steel		3 RMP (SR)		6 Asbestos-Cement		Welded	
2 PVC		4 ABS		7 Fiberglass		Threaded	
Blank casing diameter in. to ft., Dia in. to ft., Dia in. to ft.							
Casing height above land surface in., weight lbs./ft.		Wall thickness or gauge No.					
TYPE OF SCREEN OR PERFORATION MATERIAL:				7 PVC			
1 Steel		3 Stainless steel		5 Fiberglass		8 RMP (SR)	
2 Brass		4 Galvanized steel		6 Concrete tile		9 ABS	
				10 Asbestos-cement			
				11 Other (specify)			
				12 None used (open hole)			
SCREEN OR PERFORATION OPENINGS ARE:				5 Gauzed wrapped		8 Saw cut	
1 Continuous slot		3 Mill slot		6 Wire wrapped		9 Drilled holes	
2 Louvered shutter		4 Key punched		7 Torch cut		10 Other (specify)	
SCREEN-PERFORATED INTERVALS:		From ft. to ft.,		From ft. to ft.,		From ft. to ft.	
		From ft. to ft.,		From ft. to ft.,		From ft. to ft.	
GRAVEL PACK INTERVALS:		From ft. to ft.,		From ft. to ft.,		From ft. to ft.	
		From ft. to ft.,		From ft. to ft.,		From ft. to ft.	

6] GROUT MATERIAL:		1 Neat cement	2 Cement grout	3 Bentonite	4 Other
Grout Intervals:		From ft. to	ft., From ft. to	ft., From ft. to	ft.
What is the nearest source of possible contamination:				10 Livestock pens	14 Abandoned water well
1 Septic tank	4 Lateral lines	7 Pit privy	11 Fuel storage	15 Oil well/Gas well	
2 Sewer lines	5 Cess pool	8 Sewage lagoon	12 Fertilizer storage	16 Other (specify below)	
3 Watertight sewer lines	6 Seepage pit	9 Feedyard	13 Insecticide storage	None	
Direction from well?				How many feet?	

[illegible]

7 CONTRACTOR'S OR LANDOWNER'S CERTIFICATION: This water well was (1) constructed, (2) reconstructed, or (3) plugged under my jurisdiction and was completed on (mo/day/year) 9/27/89 and this record is true to the best of my knowledge and belief. Kansas Water Well Contractor's License No. 186 This Water Well Record was completed on (mo/day/yr) 10/16/89 under the business name of Kelly's Water Well by (signature) [Signature]

INSTRUCTIONS: Use typewriter or ball point pen. PLEASE PRESS FIRMLY and PRINT clearly. Please fill in blanks, underline or circle the correct answers. Send top three copies to Kansas Department of Health and Environment, Bureau of Water Protection, Topeka, Kansas 66620-7320. Telephone: 913-296-5514. Send one to WATER WELL OWNER and retain one for your records.