


1 LOCATION OF WATER WELL:	Fraction	Section Number	Township Number	Range Number
County: BARTON	SE 1/4 SE 1/4 NW 1/4	33	T 19 S	R 13 EW

Distance and direction from nearest town or city street address of well if located within city?

in town

2 WATER WELL OWNER:	Board of Agriculture, Division of Water Resources
RR#, St. Address, Box # : 2017 MAIN	Application Number:
City, State, ZIP Code : GREAT BEND, KS.	

3 LOCATE WELL'S LOCATION WITH AN "X" IN SECTION BOX:	4 DEPTH OF COMPLETED WELL 19.0 ft. ELEVATION:
--	--

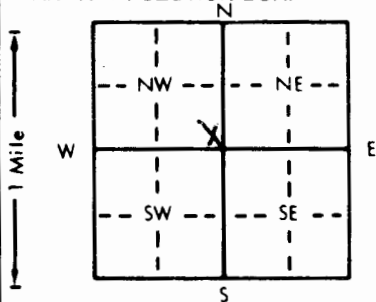

1 Domestic 3 Feedlot 6 Oil field water supply 9 Dewatering 12 Other (Specify below)	5 Public water supply 8 Air conditioning 11 Injection well
2 Irrigation 4 Industrial 7 Lawn and garden only 10 Monitoring well	

2 PVC 4 ABS	7 Fiberglass		Threaded
Blank casing diameter 2 in. to 9.0 ft. Dia 2 in. to 9.0 ft. Dia 2 in. to 9.0 ft.			
Casing height above land surface 0 in., weight 0 lbs./ft. Wall thickness or gauge No. 0			

TYPE OF SCREEN OR PERFORATION MATERIAL:	1 Steel 3 Stainless steel 5 Fiberglass 8 RMP (SR) 11 Other (specify)
2 Brass 4 Galvanized steel 6 Concrete tile 9 ABS 12 None used (open hole)	

SCREEN OR PERFORATION OPENINGS ARE:	5 Gauzed wrapped 8 Saw cut 11 None (open hole)
1 Continuous slot 3 Mill slot 6 Wire wrapped 9 Drilled holes	
2 Louvered shutter 4 Key punched 7 Torch cut 10 Other (specify)	

SCREEN-PERFORATED INTERVALS:	From 9.0 ft. to 19.0 ft. From 9.0 ft. to 19.0 ft.
GRAVEL PACK INTERVALS:	From 8.0 ft. to 19.0 ft. From 8.0 ft. to 19.0 ft.

6 GROUT MATERIAL:	1 Neat cement 2 Cement grout 3 Bentonite 4 Other
Grout Intervals: From 0 ft. to 1.0 ft. From 1.0 ft. to 1.0 ft. From 1.0 ft. to 6.0 ft. From 6.0 ft. to 8.0 ft.	

What is the nearest source of possible contamination:	10 Livestock pens 14 Abandoned water well
1 Septic tank 4 Lateral lines 7 Pit privy 11 Fuel storage 15 Oil well/Gas well	
2 Sewer lines 5 Cess pool 8 Sewage lagoon 12 Fertilizer storage 16 Other (specify below)	
3 Watertight sewer lines 6 Seepage pit 9 Feedyard 13 Insecticide storage	

Direction from well?	How many feet?
----------------------	----------------

FROM	TO	LITHOLOGIC LOG	FROM	TO	PLUGGING INTERVALS
0	.5	GRAVEL (F.I.I)			
.5	4.0	Clay w/silt dark brown			
4.0	8.0	Clay w/silt + brown			
8.0	19.0	Sand, med. to coarse			
		GRAINED, wet at 11'			
		black petroleum stain			

7 CONTRACTOR'S OR LANDOWNER'S CERTIFICATION: This water well was (1) constructed, (2) reconstructed, or (3) plugged under my jurisdiction and was completed on (mo/day/year) 6-27-94 and this record is true to the best of my knowledge and belief. Kansas
Water Well Contractor's License No. 938 This Water Well Record was completed on (mo/day/yr) 6-30-94
under the business name of KCTL by (signature) James R. Brinkley