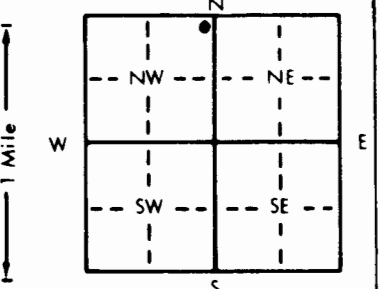


1 LOCATION OF WATER WELL:		Fraction		Section Number		Township Number		Range Number	
County: Barton		NE 1/4 NE 1/4 NW 1/4		33		T 19 S		R 13 E	
2 WATER WELL OWNER: Duane Byrd									
RR#, St. Address, Box #: 2901 W. 10th St									
City, State, ZIP Code: Great Bend, KS. 67530									
3 LOCATE WELL'S LOCATION WITH AN "X" IN SECTION BOX:									
									
4 DEPTH OF COMPLETED WELL: 15'6" ft. ELEVATION: 711.87 ft.									
WELL'S STATIC WATER LEVEL: 7.45 ft. below land surface measured on mo/day/yr									
Pump test data: Well water was ... ft. after ... hours pumping ... gpm									
Est. Yield ... gpm: Well water was ... ft. after ... hours pumping ... gpm									
Bore Hole Diameter: 8 1/2" in. to 15'6" ft., and ... in. to ... ft.									
WELL WATER TO BE USED AS: 5 Public water supply 8 Air conditioning 11 Injection well									
1 Domestic 3 Feedlot 6 Oil field water supply 9 Dewatering 12 Other (Specify below)									
2 Irrigation 4 Industrial 7 Lawn and garden only 10 Monitoring well									
Was a chemical/bacteriological sample submitted to Department? Yes No X If yes, mo/day/yr sample was submitted									
Water Well Disinfected? Yes No									
5 TYPE OF BLANK CASING USED:									
1 Steel 3 RMP (SR) 5 Wrought iron 8 Concrete tile CASING JOINTS: Glued Clamped									
2 PVC 4 ABS 6 Asbestos-Cement 9 Other (specify below) Welded X									
7 Fiberglass Threaded									
Blank casing diameter 2.375 in. to 5 ft. Dia ... in. to ... ft. Dia ... in. to ... ft.									
Casing height above land surface Flush Mount in. weight ... lbs./ft. Wall thickness or gauge No. SDR 13									
TYPE OF SCREEN OR PERFORATION MATERIAL: 7 PVC 10 Asbestos-cement SCH 40									
1 Steel 3 Stainless steel 5 Fiberglass 8 RMP (SR) 11 Other (specify)									
2 Brass 4 Galvanized steel 6 Concrete tile 9 ABS 12 None used (open hole)									
SCREEN OR PERFORATION OPENINGS ARE:									
1 Continuous slot 3 Mill slot 5 Gauzed wrapped 8 Saw cut 11 None (open hole)									
2 Louvered shutter 4 Key punched 6 Wire wrapped 9 Drilled holes									
7 Torch cut 10 Other (specify)									
SCREEN-PERFORATED INTERVALS: From 15' ft. to 5' ft. From ... ft. to ... ft.									
GRAVEL PACK INTERVALS: From 15'6" ft. to 4' ft. From ... ft. to ... ft.									
6 GROUT MATERIAL:									
1 Neat cement 2 Cement grout 3 Bentonite 4 Other									
Grout Intervals: From 4' ft. to 3' ft. From 3' ft. to 0' ft. From ... ft. to ... ft.									
What is the nearest source of possible contamination:									
1 Septic tank 4 Lateral lines 7 Pit privy 10 Livestock pens 14 Abandoned water well									
2 Sewer lines 5 Cess pool 8 Sewage lagoon 11 Fuel storage 15 Oil well/Gas well									
3 Watertight sewer lines 6 Seepage pit 9 Feedyard 12 Fertilizer storage 16 Other (specify below)									
13 Insecticide storage									
Direction from well? West Southwest How many feet? 10'									
FROM TO LITHOLOGIC LOG FROM TO PLUGGING INTERVALS									
0 1 Broken concr. w/ sand underlay									
1 3.50 Dk gray silty clay w/ some fine sand, mod. to strong odor, moist, soft.									
3.50 5.50 Gray green silty sand, moist, strong odor.									
5.50 15'6" Black sand, fine-coarse grained, wet at 9 1/2', very strong odor, well graded, poorly sorted.									
7 CONTRACTOR'S OR LANDOWNER'S CERTIFICATION: This water well was (1) constructed (2) reconstructed, or (3) plugged under my jurisdiction and was completed on (mo/day/year) 7-12-94 and this record is true to the best of my knowledge and belief. Kansas Water Well Contractor's License No. 539 This Water Well Record was completed on (mo/day/yr) 7-21-94 under the business name of JB Environmental Drilling by (signature) James Bieler									