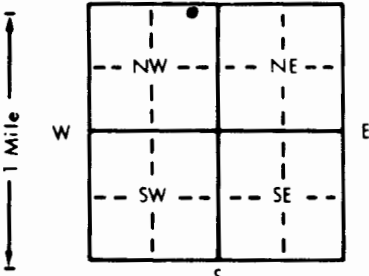


1 LOCATION OF WATER WELL: County: Barton	Fraction NE $\frac{1}{4}$ DE $\frac{1}{4}$ NW $\frac{1}{4}$	Section Number 33	Township Number T 19 S	Range Number R 13 EW
--	---	-----------------------------	----------------------------------	--------------------------------

Distance and direction from nearest town or city street address of well if located within city?

Steve's Standard 10th & Main Great Bend, Ks.

2 WATER WELL OWNER: Steve Boyd RR#, St. Address, Box # : 1001 Main City, State, ZIP Code : Great Bend, Ks. 67530	Board of Agriculture, Division of Water Resources Application Number:
---	--

3 LOCATE WELL'S LOCATION WITH AN "X" IN SECTION BOX: 	4 DEPTH OF COMPLETED WELL: 15'6" ft. ELEVATION: Depth(s) Groundwater Encountered 1. 9' ft. 2. ft. 3. ft. WELL'S STATIC WATER LEVEL 7.30 ft. below land surface measured on mo/day/yr 7-18-94 Pump test data: Well water was ft. after hours pumping gpm Est. Yield gpm: Well water was ft. after hours pumping gpm Bore Hole Diameter 8 1/2" in. to 15'6" ft., and in. to ft. WELL WATER TO BE USED AS: 5 Public water supply 8 Air conditioning 11 Injection well 1 Domestic 3 Feedlot 6 Oil field water supply 9 Dewatering 12 Other (Specify below) 2 Irrigation 4 Industrial 7 Lawn and garden only 10 Monitoring well Was a chemical/bacteriological sample submitted to Department? Yes No X ; If yes, mo/day/yr sample was submitted Water Well Disinfected? Yes No
--	--

5 TYPE OF BLANK CASING USED: 1 Steel 2 PVC Blank casing diameter 2.375 in. to 5' ft., Dia. in. to ft., Dia. in. to ft. Casing height above land surface Flush Mount in., weight lbs./ft. Wall thickness or gauge No. SDR 13 TYPE OF SCREEN OR PERFORATION MATERIAL: 1 Steel 3 Stainless steel 5 Fiberglass 8 RMP (SR) 10 Asbestos-cement 2 Brass 4 Galvanized steel 6 Concrete tile 9 ABS 11 Other (specify) Sch 40 12 None used (open hole) SCREEN OR PERFORATION OPENINGS ARE: 1 Continuous slot 3 Mill slot 5 Gauzed wrapped 8 Saw cut 11 None (open hole) 2 Louvered shutter 4 Key punched 6 Wire wrapped 9 Drilled holes 7 Torch cut 10 Other (specify) SCREEN-PERFORATED INTERVALS: From 15' ft. to 5' ft. From ft. to ft. GRAVEL PACK INTERVALS: From 15'6" ft. to 4' ft. From ft. to ft.	CASING JOINTS: Glued Clamped Welded Threaded X
--	---

6 GROUT MATERIAL: 1 Neat cement 2 Cement grout 3 Bentonite 4 Other Grout Intervals: From 4' ft. to 3' ft. From 3' ft. to 0' ft. From ft. to ft. What is the nearest source of possible contamination: 1 Septic tank 4 Lateral lines 7 Pit privy 10 Livestock pens 14 Abandoned water well 2 Sewer lines 5 Cess pool 8 Sewage lagoon 11 Fuel storage 15 Oil well/Gas well 3 Watertight sewer lines 6 Seepage pit 9 Feedyard 12 Fertilizer storage 16 Other (specify below) 13 Insecticide storage Direction from well? East How many feet? 20'
--

FROM	TO	LITHOLOGIC LOG	FROM	TO	PLUGGING INTERVALS
0	.75	Concrete			
.75	3.50	Dk green-dk gray silty clay, friable, dry.			
3.50	8.25	Olive green silty sand, soft, mod. odor.			
8.25	15'6"	Dk gray fine-coarse grained sand, wet at 9', strong odor.			

7 CONTRACTOR'S OR LANDOWNER'S CERTIFICATION: This water well was (1) constructed , (2) reconstructed, or (3) plugged under my jurisdiction and was completed on (mo/day/year) 7-14-94 and this record is true to the best of my knowledge and belief. Kansas Water Well Contractor's License No. 539 This Water Well Record was completed on (mo/day/yr) 7-21-94 under the business name of JB Environmental Drilling by (signature) James Goken
--