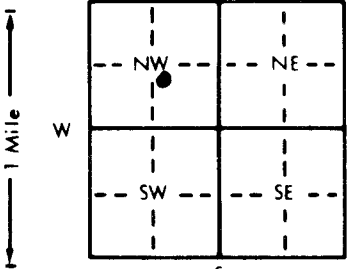


1 LOCATION OF WATER WELL: County: Barton		Fraction NW 1/4 SE 1/4 NW 1/4	Section Number 33	Township Number T 19 S	Range Number R 13 E (W)
Distance and direction from nearest town or city street address of well if located within city? 6th & Morton, Great Bend, Ks.					
2 WATER WELL OWNER: RR#, St. Address, Box # : City, State, ZIP Code		City of Great Bend 1209 Williams Great Bend, K. 67530 Board of Agriculture, Division of Water Resources Application Number:			
3 LOCATE WELL'S LOCATION WITH AN "X" IN SECTION BOX: 		4 DEPTH OF COMPLETED WELL 15'6" ft. ELEVATION: Depth(s) Groundwater Encountered 1. 9'6" ft. 2. ft. 3. ft. WELL'S STATIC WATER LEVEL 8'8" ft. below land surface measured on mo/day/yr 6-8-94 Pump test data: Well water was ft. after hours pumping gpm Est. Yield gpm: Well water was ft. after hours pumping gpm Bore Hole Diameter 8 1/2" in. to 15'6" ft. and in. to ft. WELL WATER TO BE USED AS: 1 Domestic 3 Feedlot 6 Oil field water supply 8 Air conditioning 11 Injection well 2 Irrigation 4 Industrial 7 Lawn and garden only 9 Dewatering 12 Other (Specify below) Was a chemical/bacteriological sample submitted to Department? Yes No X; If yes, mo/day/yr sample was submitted Water Well Disinfected? Yes (No)			
5 TYPE OF BLANK CASING USED: 1 Steel 2 PVC 3 RMP (SR) 4 ABS Blank casing diameter 2.375 in. to 5' ft. Dia Casing height above land surface Flush Height in. weight lbs./ft. Wall thickness or gauge No. SDR 13 SCH 40 TYPE OF SCREEN OR PERFORATION MATERIAL: 1 Steel 3 Stainless steel 5 Fiberglass 8 RMP (SR) 10 Asbestos-cement 2 Brass 4 Galvanized steel 6 Concrete tile 9 ABS 11 Other (specify) 12 None used (open hole) SCREEN OR PERFORATION OPENINGS ARE: 1 Continuous slot 2 Mill slot 3 Gauzed wrapped 4 Wire wrapped 5 Torch cut 6 Saw cut 7 Drilled holes 8 None (open hole) SCREEN-PERFORATED INTERVALS: From 15' ft. to 5' ft. From ft. to ft. From ft. to ft. From ft. to ft. GRAVEL PACK INTERVALS: From 15'6" ft. to 4' ft. From ft. to ft. From ft. to ft. From ft. to ft.		CASING JOINTS: Glued Clamped Welded Threaded X 10 Livestock pens 14 Abandoned water well 11 Fuel storage 15 Oil well/Gas well 12 Fertilizer storage 16 Other (specify below) 13 Insecticide storage How many feet? 175'			
6 GROUT MATERIAL: 1 Neat cement 2 Cement grout 3 Bentonite 4 Other Grout Intervals: From ft. to ft. From ft. to ft. From ft. to ft. From ft. to ft. What is the nearest source of possible contamination: 1 Septic tank 4 Lateral lines 7 Pit privy 10 Livestock pens 14 Abandoned water well 2 Sewer lines 5 Cess pool 8 Sewage lagoon 11 Fuel storage 15 Oil well/Gas well 3 Watertight sewer lines 6 Seepage pit 9 Feedyard 12 Fertilizer storage 16 Other (specify below) Direction from well? South		LITHOLOGIC LOG FROM TO 0 .50 Asphalt .50 2.75 Dk gray-blk silty clay, mottled, no odor. 2.75 6 Yellow tan sandy silt to silt, moist, friable, no odor. 6 9.25 Tan sand, fine grained, dry,, no odor, iron oxides. 9.25 15'6 Tan sand & gravel, fine-very coarse sand & gravel w/ few cobbles, wet at 9'6, no odor.			
7 CONTRACTOR'S OR LANDOWNER'S CERTIFICATION: This water well was (1) constructed (2) reconstructed, or (3) plugged under my jurisdiction and was completed on (mo/day/year) 6-7-94 and this record is true to the best of my knowledge and belief. Kansas Water Well Contractor's License No. 539 This Water Well Record was completed on (mo/day/yr) 6-9-94 under the business name of JB Environmental Drilling by (signature) James Becker					

INSTRUCTIONS: Use typewriter or ball point pen. PLEASE PRESS FIRMLY and PRINT clearly. Please fill in blanks, underline or circle the correct answers. Send top three copies to Kansas Department of Health and Environment, Bureau of Water, Topeka, Kansas 66620-0001. Telephone: 913-296-5545. Send one to WATER WELL OWNER and retain one for your records.