USE TYPEWRITER OR BALL POINT PEN-PRESS FIRMLY, PRINT CLEARLY.

WATER WELL RECORD
KSA 82a-1201-1215

Kansas Department of Health and Environment-Division of Environment
(Water well Contractors)
Topeka, Kansas 66620

1. Location of well:	County	Fraction	Section number	Township number	Range number
	Barton	C 1/4 ½ 1/4 NW 1/4	36	T 19 S	R 13 E/W

2. Distance and direction from nearest town or city:
1½ mi. East of Great Bend, Kansas
Street address of well location if in city:

3. Owner of well:
R.R. or street: Matthews Construction Co., Inc. Rt. #3
City, state, zip code: Great Bend, Kansas 67530

4. Locate with "X" in section below:

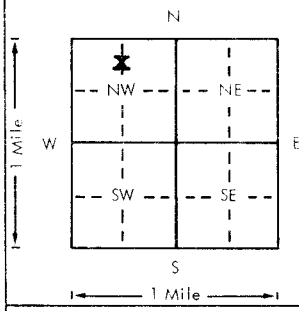

Sketch map:

6. Bore hole dia. 9 7/8 in. Completion date 4-4-78
Well depth 60 ft.

7. __ Cable tool X Rotary __ Driven __ Dug
__ Hollow rod __ Jetted __ Bored __ Reverse rotary

8. Use: __ Domestic __ Public supply __ Industry
__ Irrigation __ Air conditioning __ Stock
X Lawn __ Oil field water __ Other

9. Casing: Material pvc Height: Above or below
Threaded __ Welded __ Surface 18 in.
RMP __ PVC X Weight __ lbs./ft.
Dia. 5½ in. to 60 ft. depth Wall Thickness: inches or
Dia. __ in. to __ ft. depth gage No. .258

5. Type and color of material	From	To
Top soil	0	3
Clay	3	5
Gravel	5	29
Clay	29	34
Good sand & gravel	34	60

(Use a second sheet if needed)

10. Screen: Manufacturer's name CertainTeed
Type pvc Dia. 5 1/2
Slot/gage 1/32 Length 20
Set between 40 ft. and 60 ft.
__ ft. and __ ft.
Gravel pack? X Size range of material ⅛ 3/4 3/8

11. Static water level: mo./day/yr.
14 ft. below land surface Date 4-4-78

12. Pumping level below land surfaces:
14 ft. after 1 hrs. pumping 120 g.p.m.
__ ft. after __ hrs. pumping __ g.p.m.
Estimated maximum yield 300 g.p.m.

13. Water sample submitted: mo./day/yr.
__ Yes X No Date

14. Well head completion:
__ Pitless adapter __ Inches above grade

15. Well grouted? X
With: X Neat cement __ Bentonite __ Concrete
Depth: From 0 ft. to 16 ft.

16. Nearest source of possible contamination:
ft. 375 Direction WEST Type septic
Well disinfected upon completion? HTH Yes __ No

17. Pump: X Not installed
Manufacturer's name
Model number HP Volts
Length of drop pipe ft. capacity g.p.m.
Type:
__ Submersible __ Turbine
__ Jet __ Reciprocating
__ Centrifugal __ Other

18. Elevation:
Topography:
__ Hill
__ Slope
__ Upland
X Valley

19. Remarks:

20. Water well contractor's certification:
This well was drilled under my jurisdiction and this report is true to the best of my knowledge and belief.
Rosencrantz-Bemis 134
Business name License No.
Address Great Bend, Kansas 67530
Signed Sandy Lilyquist Date 4-6-78
Authorized representative

T 19 R 13 E/W Sec 36 1/4 1/4 1/4 1/4

Forward the white, blue and pink copies to the Department of Health and Environment

Form WWC-5

MI-1023