WATER WELL PLUGGING RECORD Form WWC-5P KSA 82a-1212 ID NO. _____

| 1 LOCATION OF WATER WELL: | Fraction | Section Number | Township Number | Range Number |
|---|---|---|---|---|
| County: Barton | NE¼ NE¼ NE¼ | 29 | 19 | 13W |

Distance and direction from nearest town or city street address of well if located within city?
180' S of the SW corner of 24th St + Washington St.

2 WATER WELL OWNER: Presta Oil Co.
RR #, St. Address, Box #: Jerry Presta
City, State, ZIP Code : Box 1709 Garden City, KS 67846

Board of Agriculture, Division of Water Resources
Application Number:

3 MARK WELL'S LOCATION WITH AN "X" IN SECTION BOX:

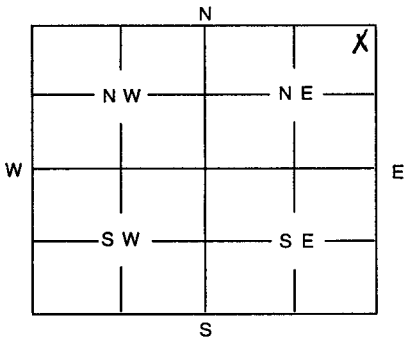


4 DEPTH OF WELL 20 ft

WELL'S STATIC WATER LEVEL 13.40 ft.

WELL WAS USED AS:

1 Domestic 5 Public Water Supply 9 Dewatering
2 Irrigation 6 Oil Field Water Supply (10) Monitoring Well
3 Feedlot 7 Domestic (Lawn & Garden) 11 Injection Well
4 Industrial 8 Air Conditioning 12 Other .....

Was a chemical / bacteriological sample submitted to Department? Yes ..... No ✓
If yes, mo/day/yr sample was submitted .....

Water Well Disinfected: Yes ..... No ✓

5 TYPE OF BLANK CASING USED:

1 Steel 3 RMP (SR) 5 Wrought 7 Fiberglass 9 Other (Specify below)
(2) PVC 4 ABS 6 Asbestos-Cement 8 Concrete Tile .....

Blank casing diameter 2 in. Was casing pulled? Yes ✓ No ..... If yes, how much 10'
Casing height above or below land surface 0 in.

6 GROUT PLUG MATERIAL: 1 Neat cement 2 Cement grout (3) Bentonite (4) Other Cement

Grout Plug Intervals: From 0 ft. to 3 ft., From 3 ft. to 20 ft., From ..... to ..... ft.

What is the nearest source of possible contamination:

1 Septic tank 6 Seepage pit 11 Fuel storage 16 Other (specify below)
2 Sewer lines 7 Pit privy 12 Fertilizer storage .....
3 Watertight sewer lines 8 Sewage lagoon 13 Insecticide storage
4 Lateral lines 9 Feedyard 14 Abandoned water well
5 Cess Pool 10 Livestock pens 15 Oil well/Gas well

Direction from well? ..... How many feet? .....

Drilled well out to 13'

| FROM | TO | PLUGGING MATERIALS |
|---|---|---|
| 0 | 3 | Cement |
| 3 | 20 | Bentonite |
| | | |
| | | |
| | | MW1 |
| | | |
| | | tag#00064912 |

7 CONTRACTOR'S OR LANDOWNER'S CERTIFICATION: This water well was plugged under my jurisdiction and was completed on (mo/day/year) 2-3-00 and this record is true to the best of my knowledge and belief. Kansas Water Well Contractor's License No. 527 This Water Well Record was completed on (mo/day/year) 2-7-00 under the business name of GeoCore Services, Inc.
by (signature) Dale Robe

INSTRUCTIONS: Use typewriter or ball point pen. Please press firmly and print clearly. Please fill in blanks, underline or circle the correct answers. Send top three copies to Kansas Department of Health and Environment, Bureau of Water, Topeka, Kansas 66620-0001. Telephone: 785/296-3565. Send one to Water Well Owner and retain one for your records.