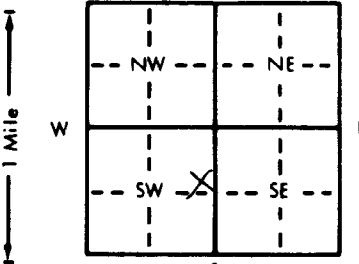


1 LOCATION OF WATER WELL:		Fraction	Section Number	Township Number	Range Number
County: Barton		SE 1/4 NE 1/4 SW 1/4	28	T 19 S	R 13 E
Distance and direction from nearest town or city street address of well if located within city? 1410 Williams Great Bend KS					
2 WATER WELL OWNER: Fm Parish Mohr Co 1410 Williams Great Bend, KS RR#, St. Address, Box # : City, State, ZIP Code : Board of Agriculture, Division of Water Resources Application Number:					
3 LOCATE WELL'S LOCATION WITH AN "X" IN SECTION BOX:		4 DEPTH OF COMPLETED WELL: 20 ft. ELEVATION: 418/00			
		Depth(s) Groundwater Encountered: 14.645 ft. 2. ft. 3. ft. WELL'S STATIC WATER LEVEL: 14.645 ft. below land surface measured on mo/day/yr Pump test data: Well water was ft. after hours pumping gpm Est. Yield gpm: Well water was ft. after hours pumping gpm Bore Hole Diameter: 8.625 in. to 20 ft. and in. to ft. WELL WATER TO BE USED AS: 1 Domestic 3 Feedlot 6 Oil field water supply 9 Dewatering 12 Other (Specify below) 2 Irrigation 4 Industrial 7 Lawn and garden only 10 Monitoring well MW-3 Was a chemical/bacteriological sample submitted to Department? Yes No X; If yes, mo/day/yr sample was submitted Water Well Disinfected? Yes No X			
5 TYPE OF BLANK CASING USED: 1 Steel 3 RMP (SR) 5 Wrought iron 8 Concrete tile CASING JOINTS: Glued Clamped 2 PVC 4 ABS 6 Asbestos-Cement 9 Other (specify below) Welded Blank casing diameter: 2 in. to 10 ft., Dia. in. to ft., Dia. in. to ft. Casing height above land surface: flush in., weight: 50 lbs./ft. Wall thickness or gauge No. TYPE OF SCREEN OR PERFORATION MATERIAL: 1 Steel 3 Stainless steel 5 Fiberglass 8 RMP (SR) 10 Asbestos-cement 2 Brass 4 Galvanized steel 6 Concrete tile 9 ABS 11 Other (specify) 12 None used (open hole) SCREEN OR PERFORATION OPENINGS ARE: 1 Continuous slot 3 Mill slot 5 Gauzed wrapped 8 Saw cut 11 None (open hole) 2 Louvered shutter 4 Key punched 6 Wire wrapped 9 Drilled holes SCREEN-PERFORATED INTERVALS: From 20 ft. to 10 ft. From ft. to ft. GRAVEL PACK INTERVALS: From 20 ft. to 9 ft. From ft. to ft. 6 GROUT MATERIAL: 1 Neat cement 3 Cement grout 5 Bentonite 4 Other Grout Intervals: From 9 ft. to 6 ft. From 6 ft. to 0 ft. From ft. to ft. What is the nearest source of possible contamination: 1 Septic tank 4 Lateral lines 7 Pit privy 10 Livestock pens 14 Abandoned water well 2 Sewer lines 5 Cess pool 8 Sewage lagoon 11 Fuel storage 15 Oil well/Gas well 3 Watertight sewer lines 6 Seepage pit 9 Feedyard 12 Fertilizer storage 18 Other (specify below) Contaminated site 13 Insecticide storage Direction from well? How many feet?					
FROM TO LITHOLOGIC LOG		FROM TO PLUGGING INTERVALS			
0	1	Asphalt fill			
1	3	Clay w/ some silt			
3	8	silt w/ some clay			
8	20	sand w/ some silt			
20	TD	end of borehole			
7 CONTRACTOR'S OR LANDOWNER'S CERTIFICATION: This water well was (1) constructed, (2) reconstructed, or (3) plugged under my jurisdiction and was completed on (mo/day/year) 3/24/00 and this record is true to the best of my knowledge and belief. Kansas Water Well Contractor's License No. 585 This Water Well Record was completed on (mo/day/yr) under the business name of ACEI by (signature)					