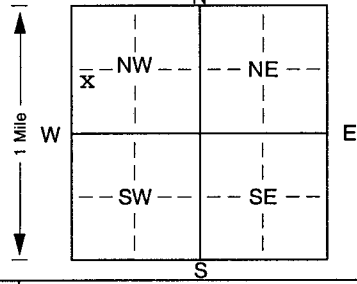
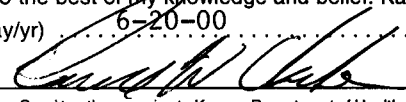


1 LOCATION OF WATER WELL:		Fraction	Section Number	Township Number	Range Number
County: Barton		NW ¼ SW ¼ NW ¼	29	T 19 S	R 13 E W
Distance and direction from nearest town or city street address of well if located within city? At 3816 21st Street					
2 WATER WELL OWNER:		John Strobel			
RR#, St. Address, Box # :		3816 21st Street		Board of Agriculture, Division of Water Resources	
City, State, ZIP Code :		Great Bend, KS 67530		Application Number:	
3 LOCATE WELL'S LOCATION WITH AN "X" IN SECTION BOX:		4 DEPTH OF COMPLETED WELL: 60 ft. ELEVATION: unknown			
		Depth(s) Groundwater Encountered 1. ft. 2. ft. 3. ft.			
		WELL'S STATIC WATER LEVEL 15.01 . . . ft. below land surface measured on mo/day/yr . . . 6-19-00			
		Pump test data: Well water was not ch'd. ft. after hours pumping gpm			
		Est. Yield unknown gpm: Well water was ft. after hours pumping gpm			
		Bore Hole Diameter. . . 8 . . . in. to . . . 60 . . . ft., and in. to ft.			
WELL WATER TO BE USED AS:		5 Public water supply 8 Air conditioning 11 Injection well			
1 Domestic 3 Feedlot 6 Oil field water supply 9 Dewatering 12 Other (Specify below)					
2 Irrigation 4 Industrial 7 Domestic (lawn & garden) 10 Monitoring well					
Was a chemical/bacteriological sample submitted to Department? Yes. No. ☒ ; If yes, mo/day/yr sample was submitted					
Water Well Disinfected? Yes No ☒					
5 TYPE OF BLANK CASING USED:					
1 Steel 3 RMP (SR)		5 Wrought iron 8 Concrete tile		CASING JOINTS: Glued. ☒ Clamped.	
2 PVC 4 ABS		6 Asbestos-Cement 9 Other (specify below)		Welded	
7 Fiberglass				Threaded.	
Blank casing diameter 5 in. to . . . 38 ft., Dia in. to ft., Dia in. to ft.					
Casing height above land surface. . . . 24 in., weight . . . 2.36 lbs./ft. Wall thickness or gauge No. . . . 214					
TYPE OF SCREEN OR PERFORATION MATERIAL:					
1 Steel 3 Stainless steel 5 Fiberglass 7 PVC 10 Asbestos-cement					
2 Brass 4 Galvanized steel 6 Concrete tile 8 RMP (SR) 11 Other (specify)					
		9 ABS 12 None used (open hole)			
SCREEN OR PERFORATION OPENINGS ARE:					
1 Continuous slot 3 Mill slot 5 Gauzed wrapped 8 Saw cut 11 None (open hole)					
2 Louvered shutter 4 Key punched 6 Wire wrapped 9 Drilled holes					
		7 Torch cut 10 Other (specify) ft.			
SCREEN-PERFORATED INTERVALS: From . . . 38 ft. to . . . 58 ft., From ft. to ft.					
GRAVEL PACK INTERVALS: From . . . 31 ft. to . . . 60 ft., From ft. to ft.					
6 GROUT MATERIAL: 1 Neat cement 2 Cement grout 3 Bentonite 4 Other <u>Bentonite Holeplug</u>					
Grout Intervals: From ft. to ft., From ft. to ft., From . . . 0 ft. to . . . 31 ft.					
What is the nearest source of possible contamination:					
1 Septic tank 4 Lateral lines 7 Pit privy 10 Livestock pens 14 Abandoned water well					
2 Sewer lines 5 Cess pool 8 Sewage lagoon 11 Fuel storage 15 Oil well/Gas well					
3 Watertight sewer lines 6 Seepage pit 9 Feedyard 12 Fertilizer storage 16 Other (specify below)					
		13 Insecticide storage House			
Direction from well? South How many feet? 25					
FROM	TO	LITHOLOGIC LOG	FROM	TO	PLUGGING INTERVALS
0	5	Topsoil			
5	11	Clay, brown			
11	31	Sand and gravel, caorse, medium, fine			
31	37	Clay, tan			
37	44	Sand and gravel, coarse, medium, fine			
44	49	Clay, gray			
49	60	Sand and gravel, coarse, medium, fine			
7 CONTRACTOR'S OR LANDOWNER'S CERTIFICATION: This water well was (1) <u>constructed</u> , (2) reconstructed, or (3) plugged under my jurisdiction and was completed on (mo/day/year) 6-19-00 and this record is true to the best of my knowledge and belief. Kansas Water Well Contractor's Licence No. . . . 185 This Water Well Record was completed on (mo/day/yr) . . . 6-20-00 under the business name of Clarke Well & Equipment, Inc. by (signature) 					
INSTRUCTIONS: Use typewriter or ball point pen. PLEASE PRESS FIRMLY and PRINT clearly. Please fill in blanks, underline or circle the correct answers. Send top three copies to Kansas Department of Health and Environment, Bureau of Water, Topeka, Kansas 66620-0001. Telephone 785-296-5524. Send one to WATER WELL OWNER and retain one for your records. Fee of \$5.00 for each constructed well.					