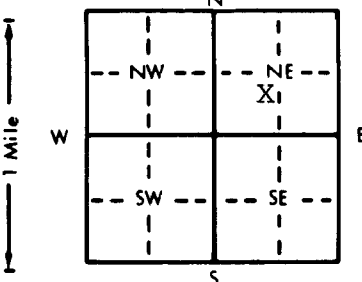


1 LOCATION OF WATER WELL:		Fraction		Section Number		Township Number		Range Number			
County: Barton		NE 1/4 SW 1/4 NE 1/4		29		T 19 S		R 13W E/W			
Distance and direction from nearest town or city street address of well if located within city?											
Downtown, Great Bend, Ks											
2 WATER WELL OWNER: Don Schloemer											
RR#, St. Address, Box #: 2808 20th											
City, State, ZIP Code: Great Bend, Ks. 67530											
Board of Agriculture, Division of Water Resources											
Application Number:											
3 LOCATE WELL'S LOCATION WITH AN "X" IN SECTION BOX:					4 DEPTH OF COMPLETED WELL: 8.5 ft. ELEVATION: unknown						
					Depth(s) Groundwater Encountered 1. 3.9 ft. 2. ft. 3. ft.						
					WELL'S STATIC WATER LEVEL 3.9 ft. below land surface measured on mo/day/yr 06/19/00						
					Pump test data: Well water was ft. after hours pumping gpm						
					Est. Yield gpm: Well water was ft. after hours pumping gpm						
					Bore Hole Diameter in. to ft., and in. to ft.						
					WELL WATER WAS USED AS:						
					5 Public water supply 8 Air conditioning 11 Injection well						
					1 Domestic WAS 3 Feedlot 6 Oil field water supply 9 Dewatering 12 Other (Specify below)						
					2 Irrigation 4 Industrial 7 Lawn and garden only 10 Monitoring well						
					Was a chemical/bacteriological sample submitted to Department? Yes No If yes, mo/day/yr sample was submitted						
					Water Well Disinfected? Yes No						
5 TYPE OF BLANK CASING USED:											
1 Steel 3 RMP (SR) 5 Wrought iron 8 Concrete tile CASING JOINTS: Glued Clamped											
2 PVC 4 ABS 6 Asbestos-Cement 9 Other (specify below) Welded											
7 Fiberglass Threaded											
Blank casing diameter 2 in. to ft., Dia in. to ft., Dia in. to ft.											
Casing height above land surface 16.5" below in., weight lbs./ft. Wall thickness or gauge No.											
TYPE OF SCREEN OR PERFORATION MATERIAL:											
1 Steel 3 Stainless steel 5 Fiberglass 8 RMP (SR) 10 Asbestos-cement											
2 Brass 4 Galvanized steel 6 Concrete tile 9 ABS 11 Other (specify)											
12 None used (open hole)											
SCREEN OR PERFORATION OPENINGS ARE:											
5 Gauzed wrapped 8 Saw cut 11 None (open hole)											
1 Continuous slot 3 Mill slot 6 Wire wrapped 9 Drilled holes											
2 Louvered shutter 4 Key punched 7 Torch cut 10 Other (specify) N/A											
SCREEN-PERFORATED INTERVALS: From N/A ft. to ft., From ft. to ft.											
From N/A ft. to ft., From ft. to ft.											
GRAVEL PACK INTERVALS: From ft. to ft., From ft. to ft.											
From ft. to ft., From ft. to ft.											
6 GROUT MATERIAL: 1 Neat cement 2 Cement grout 3 Bentonite 4 Other											
Grout intervals: From 16.5" to 8' ft., From ft. to ft., From ft. to ft.											
What is the nearest source of possible contamination:											
1 Septic tank 4 Lateral lines 7 Pit privy 10 Livestock pens 14 Abandoned water well											
2 Sewer lines 5 Cess pool 8 Sewage lagoon 11 Fuel storage 15 Oil well/Gas well											
3 Watertight sewer lines 6 Seepage pit 9 Feedyard 12 Fertilizer storage 16 Other (specify below)											
13 Insecticide storage											
Direction from well? How many feet?											
FROM		TO		LITHOLOGIC LOG		FROM		TO		PLUGGING INTERVALS	
						8'		16.5"		bentonite	
						16.5"		0		top soil	
7 CONTRACTOR'S OR LANDOWNER'S CERTIFICATION: This water well was (1) constructed, (2) reconstructed, or (3) plugged under my jurisdiction and was completed on (mo/day/year) 6/19/00 and this record is true to the best of my knowledge and belief. Kansas Water Well Contractor's License No. 186 This Water Well Record was completed on (mo/day/yr) 6/20/00 under the business name of Kelly's Water Well Service, Inc. by (signature) <i>Kathryn L. Good</i>											
INSTRUCTIONS: Use typewriter or ball point pen. PLEASE PRESS FIRMLY and PRINT clearly. Please fill in blanks, underline or circle the correct answers. Send top three copies to Kansas Department of Health and Environment, Bureau of Water, Topeka, Kansas 66620-0001. Telephone: 913-296-5545. Send one to WATER WELL OWNER and retain one for your records.											