

CORRECTION(S) TO WATER WELL RECORD (WWC-5)

(to rectify lacking or incorrect information)

County: Barton

Location listed as:

Section-Township-Range: 32-T19S-R13W

Fraction ($\frac{1}{4}$ $\frac{1}{4}$ $\frac{1}{4}$): SW SW SE

Location changed to:

33-T19S-R13W

NW SW SE

Other changes: Initial statements: _____

Changed to: _____

Comments: Location corrected based on KGS Open-file Rept. 2001-48,
where the construction of this well is discussed.

verification method: _____

initials: DAH date: Sept. 19, 2007


submitted by: Kansas Geological Survey, Data Resources Library, 1930 Constant Ave., Lawrence, KS 66047-3726
to: Kansas Dept of Health & Environment, Bureau of Water, 1000 SW Jackson, Suite 420, Topeka, KS 66612-1367.

1 LOCATION OF WATER WELL:	Fraction	Section Number	Township Number	Range Number
County: Barton	SW ¼ SW ¼ SE ¼	32	T 19 S	R 13 E/W

Distance and direction from nearest town or city street address of well if located within city?
50 East of Hiway 281 South side of Arkansas River

2	WATER WELL OWNER:	Board of Agriculture, Div. of Water Resources Project
RR#, St. Address, Box # :	KANSAS GEO. SURVEY, Lawrence, KS	Board of Agriculture, Division of Water Resources
City, State, ZIP Code :	City of Great Bend	Application Number:

3 LOCATE WELL'S LOCATION WITH AN "X" IN SECTION BOX: 4 DEPTH OF COMPLETED WELL 22.5 ft. ELEVATION:

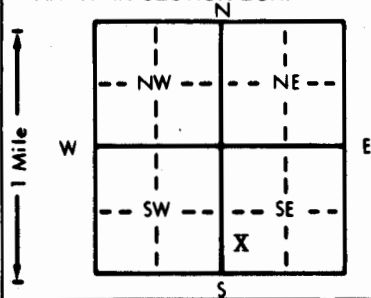

4 DEPTH OF COMPLETED WELL. 22.5 ft. ELEVATION:

Depth(s) Groundwater Encountered 1. ft. 2. ft. 3. ft.

WELL'S STATIC WATER LEVEL . . . 9. . . . ft. below land surface measured on mo/day/yr 7/26/01

Pump test data: Well water was ft. after hours pumping gpm

Est. Yield . 10 gpm: Well water was ft. after hours pumping gpm

Bore Hole Diameter . . . 3.5 . . . in. to ft., and in. to ft.

WELL WATER TO BE USED AS:

5 Public water supply	8 Air conditioning	11 Injection well		
1 Domestic	3 Feedlot	6 Oil field water supply	9 Dewatering	12 Other (Specify below)
2 Irrigation	4 Industrial	7 Lawn and garden only	10 Monitoring well	

Was a chemical/bacteriological sample submitted to Department? Yes. No. X ; If yes, mo/day/yr sample was submitted

Water Well Disinfected? Yes No

5 TYPE OF BLANK CASING USED:		5 Wrought iron	8 Concrete tile	CASING JOINTS: Glued Clamped
1 Steel	3 RMP (SR)	6 Asbestos-Cement	9 Other (specify below)	Welded
2 PVC	4 ABS	7 Fiberglass		Threaded. ☒ orings

Blank casing diameter 2 in. to ft., Dia in. to ft., Dia in. to ft.
Casing height above land surface 24 in., weight lbs./ft. Wall thickness or gauge No.

TYPE OF SCREEN OR PERFORATION MATERIAL:				
1 Steel	3 Stainless steel	5 Fiberglass	7 PVC	10 Asbestos-cement
2 Brass	4 Galvanized steel	6 Concrete tile	8 RMP (SR)	11 Other (specify)
			9 ABS	12 None used (open hole)

SCREEN OR PERFORATION OPENINGS ARE:

1 Continuous slot	3 Mill slot	5 Gauzed wrapped	8 Saw cut	11 None (open hole)
2 Louvered shutter	4 Key punched	6 Wire wrapped	9 Drilled holes	
		7 Torch cut	10 Other (specify)	

SCREEN-PERFORATED INTERVALS:	From	17	ft. to	22	ft.,	From	ft. to	ft.
	From		ft. to		ft.,	From	ft. to	ft.
GRAVEL PACK INTERVALS:	From	formation collapse	ft.,	From	ft. to	ft.		
	From		ft. to	ft.,	From	ft. to	ft.	

6 GROUT MATERIAL: 1 Neat cement 2 Cement grout 3 Bentonite 4 Other
Grout Intervals: From 0 ft. to 11 ft. From ft. to ft. From ft. to ft.

What is the nearest source of possible contamination:

1 Septic tank	4 Lateral lines	7 Pit privy	10 Livestock pens	14 Abandoned water well
2 Sewer lines	5 Cess pool	8 Sewage lagoon	11 Fuel storage	15 Oil well/Gas well
3 Watertight sewer lines	6 Seepage pit	9 Feedyard	12 Fertilizer storage	16 Other (specify below)
			13 Insecticide storage	

Direction from well?	How many feet?
-----------------------------	-----------------------

[illegible]

7 CONTRACTOR'S OR LANDOWNER'S CERTIFICATION: This water well was (1) constructed, (2) reconstructed, or (3) plugged under my jurisdiction and was completed on (mo/day/year) 7/26/01 and this record is true to the best of my knowledge and belief. Kansas Water Well Contractor's License No. _____ This Water Well Record was completed on (mo/day/yr) 8/30/01 under the business name of Kansas Geol. Survey by (signature) _____