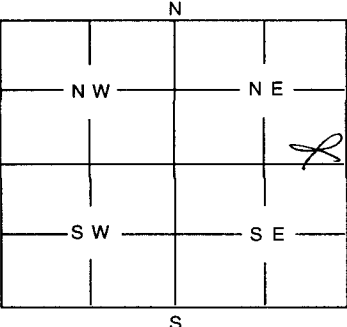


Plugging MW 9

1	LOCATION OF WATER WELL:	Fraction	Section	Number	Township	Number	Range	Number																											
	County: <u>Barton</u>	<u>SE 1/4 SE 1/4 NE 1/4</u>	<u>29</u>		<u>19S</u>		<u>13W</u>																												
Distance and direction from nearest town or city street address of well if located within city? <u>1701 N. Washington Great Bend KS</u>																																			
2	WATER WELL OWNER: <u>KDRE Time 3 Minerals</u>																																		
	RR #, St. Address, Box #: <u>Kansas Oil</u>		Board of Agriculture, Division of Water Resources																																
	City, State, ZIP Code: <u>W6-005-0036</u>		Application Number:																																
3	MARK WELL'S LOCATION WITH AN "X" IN SECTION BOX: 		4	DEPTH OF WELL <u>7.95</u> ft																															
			WELL'S STATIC WATER LEVEL <u>Dry</u> ft.																																
			WELL WAS USED AS:																																
			1 Domestic		5 Public Water Supply		9 Dewatering																												
			2 Irrigation		6 Oil Field Water Supply		10 Monitoring Well																												
			3 Feedlot		7 Domestic (Lawn & Garden)		11 Injection Well																												
			4 Industrial		8 Air Conditioning		12 Other																												
Was a chemical / bacteriological sample submitted to Department? Yes ☐ No ☒																																			
If yes, mo/day/yr sample was submitted																																			
Water Well Disinfected: Yes ☐ No ☒																																			
5	TYPE OF BLANK CASING USED:																																		
	1 Steel 3 RMP (SR) 5 Wrought 7 Fiberglass 9 Other (Specify below) ② PVC 4 ABS 6 Asbestos-Cement 8 Concrete Tile																																		
	Blank casing diameter <u>2</u> in. Was casing pulled? Yes ☒ No ☐ If yes, how much <u>3ft by dig out</u>																																		
	Casing height above or below land surface _____ in.																																		
6	GROUT PLUG MATERIAL: 1 Neat cement 2 Cement grout ③ Bentonite 4 Other																																		
	Grout Plug Intervals: From <u>3</u> ft. to <u>7.95</u> ft., From _____ ft. to _____ ft., From _____ ft. to _____ ft.																																		
What is the nearest source of possible contamination:																																			
1 Septic tank			6 Seepage pit			11 Fuel storage																													
2 Sewer lines			7 Pit privy			12 Fertilizer storage																													
3 Watertight sewer lines			8 Sewage lagoon			13 Insecticide storage																													
4 Lateral lines			9 Feedyard			14 Abandoned water well																													
5 Cess Pool			10 Livestock pens			15 Oil well/Gas well																													
①6 Other (specify below) <u>contaminated site</u>																																			
Direction from well? _____ How many feet? _____																																			
<table border="1" style="width:100%; border-collapse: collapse;"> <thead> <tr> <th style="width:10%;">FROM</th> <th style="width:10%;">TO</th> <th style="width:80%;">PLUGGING MATERIALS</th> </tr> </thead> <tbody> <tr> <td><u>0</u></td> <td><u>3</u></td> <td><u>soils</u></td> </tr> <tr> <td><u>3</u></td> <td><u>7.95</u></td> <td><u>bentonite</u></td> </tr> <tr><td> </td><td> </td><td> </td></tr> <tr><td> </td><td> </td><td> </td></tr> <tr><td> </td><td> </td><td> </td></tr> <tr><td> </td><td> </td><td> </td></tr> <tr><td> </td><td> </td><td> </td></tr> <tr><td> </td><td> </td><td> </td></tr>
7	CONTRACTOR'S OR LANDOWNER'S CERTIFICATION: This water well was plugged under my jurisdiction and was completed on (mo/day/year) <u>5/18/02</u> and this record is true to the best of my knowledge and belief. Kansas Water Well Contractor's License No. <u>585</u> This Water Well Record was completed on (mo/day/year) <u>2/14/02</u> under the business name of <u>ACI</u> by (signature) <u>Adrian H. Dew</u>																																		
INSTRUCTIONS: Use typewriter or ball point pen. Please press firmly and print clearly. Please fill in blanks, underline or circle the correct answers. Send top three copies to Kansas Department of Health and Environment, Bureau of Water, Topeka, Kansas 66620-0001. Telephone: 785/296-3565. Send one to Water Well Owner and retain one for your records.																																			