

1	LOCATION OF WATER WELL:	Fraction	Section Number	Township Number	Range Number
County:	Barton	SE $\frac{1}{4}$ NE $\frac{1}{4}$ SE $\frac{1}{4}$	22	T 19 S	R 13 E/W

Distance and direction from nearest town or city street address of well if located within city?

From Great Bend 1E, 1/2N, West side of road

2 WATER WELL OWNER: Mary Lou Button

BB# St. Address Box # : 153 NE 20 Ave.


City, State, ZIP Code : Great Bend, Ks. 67530

Board of Agriculture, Division of Water Resources

Application Number: BTWW2453

3 LOCATE WELL'S LOCATION WITH AN "X" IN SECTION BOX:

4 DEPTH OF COMPLETED WELL 58 ft. ELEVATION:

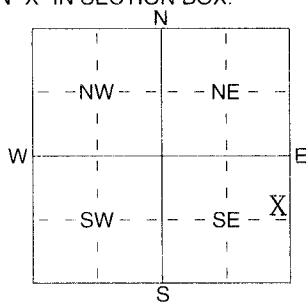

Depth(s) Groundwater Encountered ft. 2 ft. 3 ft.
WELL'S STATIC WATER LEVEL 29 ft. below land surface measured on mo/day/yr 12-13-02
Pump test data: Well water was ft. after hours pumping gpm
Est. Yield N/A gpm Well water was ft. after hours pumping gpm
WELL WATER TO BE USED AS: 5 Public water supply 8 Air conditioning 11 Injection well
1 Domestic 3 Feedlot 6 Oil field water supply 9 Dewatering 12 Other (Specify below)
2 Irrigation 4 Industrial 7 Domestic (lawn & garden) 10 Monitoring well

Was a chemical/bacteriological sample submitted to Department? Yes No X ; If yes, mo/day/yr sample was submitted
Water Well Disinfected? Yes No X

5	TYPE OF BLANK CASING USED:
---	----------------------------

5 Wrought iron

8 Concrete tile

CASING JOINTS: Glued X Clamped

1 Steel	3 RMP (SR)
2 PVC	4 ABS

6 Asbestos-Cement
7 Fiberglass

9 Other (specify below)

Welded

Blank casing diameter 5 in. to 38 ft., Dia in. to ft., Dia in. to ft.

Casing height above land surface 24 in., weight SDR- 26 lbs./ft. Wall thickness or gauge No.

TYPE OF SCREEN OR PERFORATION MATERIAL:

1 Steel	3 Stainless Steel
2 Brass	4 Galvanized Steel

5 Fiberglass
6 Concrete tile

7 PVC

10 Asbestos-Cement

1 Steel	3 Stainless Steel	5 Fiberglass	8 RMP (SR)	11 Other (Specify)
2 Brass	4 Galvanized Steel	6 Concrete tile	9 ABS	12 None used (open hole)

SCREEN OR PERFORATION OPENINGS ARE:

1 Continuous slot	3 Mill slot
2 Louvered shutter	4 Key punched

5 Guazed wrapped
6 Wire wrapped
7 Torch cut

8 Saw cut 11 None (open hole)
9 Drilled holes
10 Other (specify)

SCREEN-PERFORATED INTERVALS: From 58 ft. to 38 ft., From _____ ft. to _____ ft.

GRAVEL PACK INTERVALS: From 58 ft. to 20 ft., From ft. to ft.
From ft. to ft., From ft. to ft.

6	GROUT MATERIAL:	1 Neat cement	2 Cement grout	3 Bentonite	4 Other	hole XX plug
---	-----------------	---------------	----------------	-------------	---------	--------------

Grout Intervals: From 20 ft. to 0 ft., From _____ ft. to _____ ft., From _____ ft. to _____ ft.

What is the nearest source of possible contamination:

1 Septic tank	4 Lateral lines	7 Pit privy	11 Fuel storage	15 Oil well/Gas well
2 Sewer lines	5 Cess pool	8 Sewage lagoon	12 Fertilizer storage	16 Other (specify below)
3 Watertight sewer lines	6 Seepage pit	9 Feedyard	13 Insecticide storage	House

Direction from well? North How many feet? 50

[illegible]

7] CONTRACTOR'S OR LANDOWNER'S CERTIFICATION: This water well was (1) constructed, (2) reconstructed, or (3) plugged under my jurisdiction and was completed on (mo/day/year) 12-13-02 and this record is true to the best of my knowledge and belief. Kansas Water Well Contractor's Licence No. 134 This Water Well Record was completed on (mo/day/yr) 12-23-02 under the business name of Rosencrantz- Bemis by (signature) [Signature]