

County: Barton Fraction: SW SW SW SW Sec. 21 T. 19 S R. 13 W

CORRECTION(S) to WATER WELL COMPLETION RECORD Form WWC-5 (to rectify lacking or incorrect information)

Owner: Presto 18 MW 21

If location corrected, was listed as:

Section-Township-Range: 21-19-13W

Fraction (1/4 calls): SW SW SW

Location changed to:

SW SW SW SW

Other changes: Initial statements: _____

Changed to: _____

Latitude 38.376388 Longitude -98.774166 Elevation 1851.45


Comments: _____

Verification method: Per Bieker Surveying record and memorandum from KDHE 12-02-1-2019 used

LEOWEB for Lat/Long

Initials: SH Date: 04-17-2020

Submitted by: ☒ Kansas Geological Survey, Data Resources Library, 1930 Constant Ave., Lawrence, KS 66047-3724
☐ Kansas Dept. of Health & Environment, Bureau of Water, 1000 SW Jackson, Suite 420, Topeka, KS 66612-1367

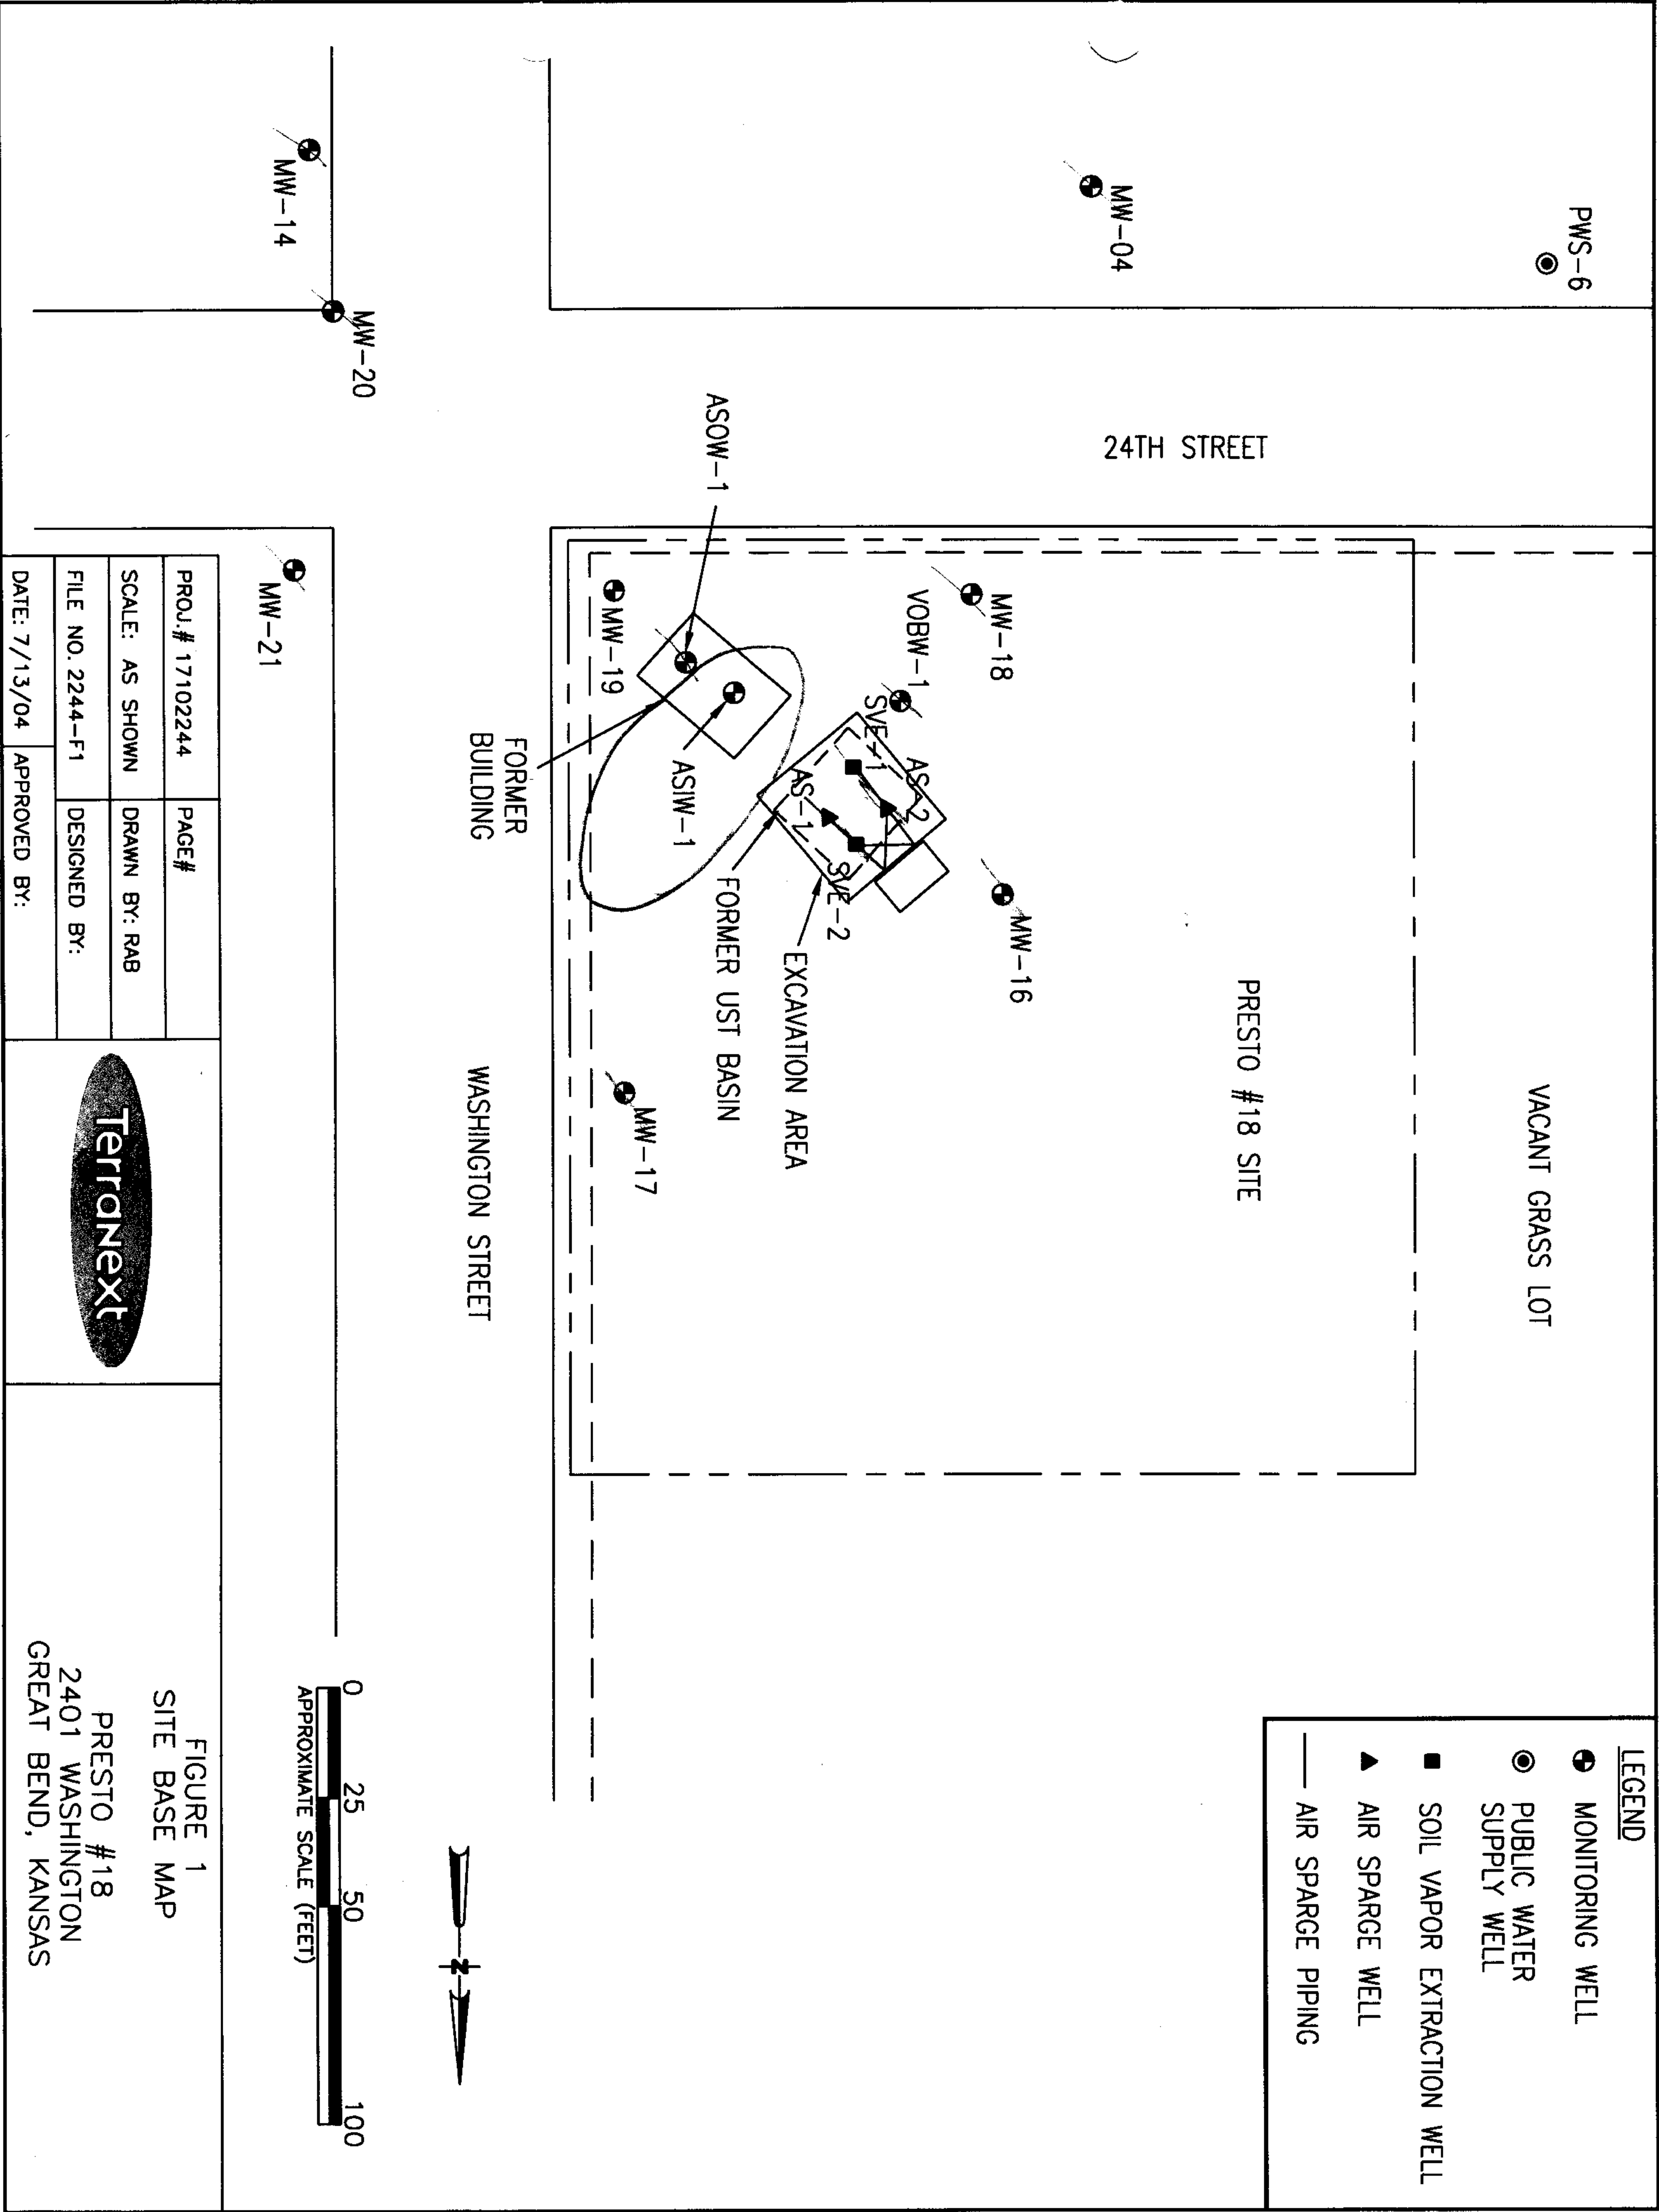

2244

BIEKER SURVEYING
1718 HENRY DRIVE
HAYS, KANSAS 67601
PHONE 785-628-8670
June 29, 2002
Page 1 of 2

BE&K TERRANEXT
13202 West 98th Street
Lenexa, Kansas 66215

Re: Surveying for Monitor Wells
Presto #18
2401 Washington Street
Great Bend, Barton County, Kansas

The above site is in Section 20, Township 19 South, Range 13 West of the Sixth Principal Meridian, Barton County, Kansas. The Southeast corner of Section 20 assigned coordinates of North 00.00 and West 00.00. The line connecting the Southeast and Northeast corners of Section 20 was assigned a bearing of North-South.

The Vertical control is from a USGS Brass cap stamped "V 29 1934" 58 feet East of center of Highway 281 and 57 feet South of center of ATSF railroad tracts. Elevation = 1849.33 feet.

The Control Point is a bolt in concrete around monitor well 19 and is 27 feet North of curb on North side of 24th Street and 31 feet West of Curb on West side of Washington Street.

The latitude and longitude were determined from GPS equipment.

The coordinates, latitude, longitude and elevations are listed on the following page of this report.



RECEIVED

DEC - 2 2019


BUREAU OF WATER RECEIVED

FEB 14 2020

KS GEOLOGICAL SURVEY

June 29, 2002
Page 2 of 2

Re: Surveying for Monitor Wells
Presto #18
2401 Washington Street
Great Bend, Barton County, Kansas

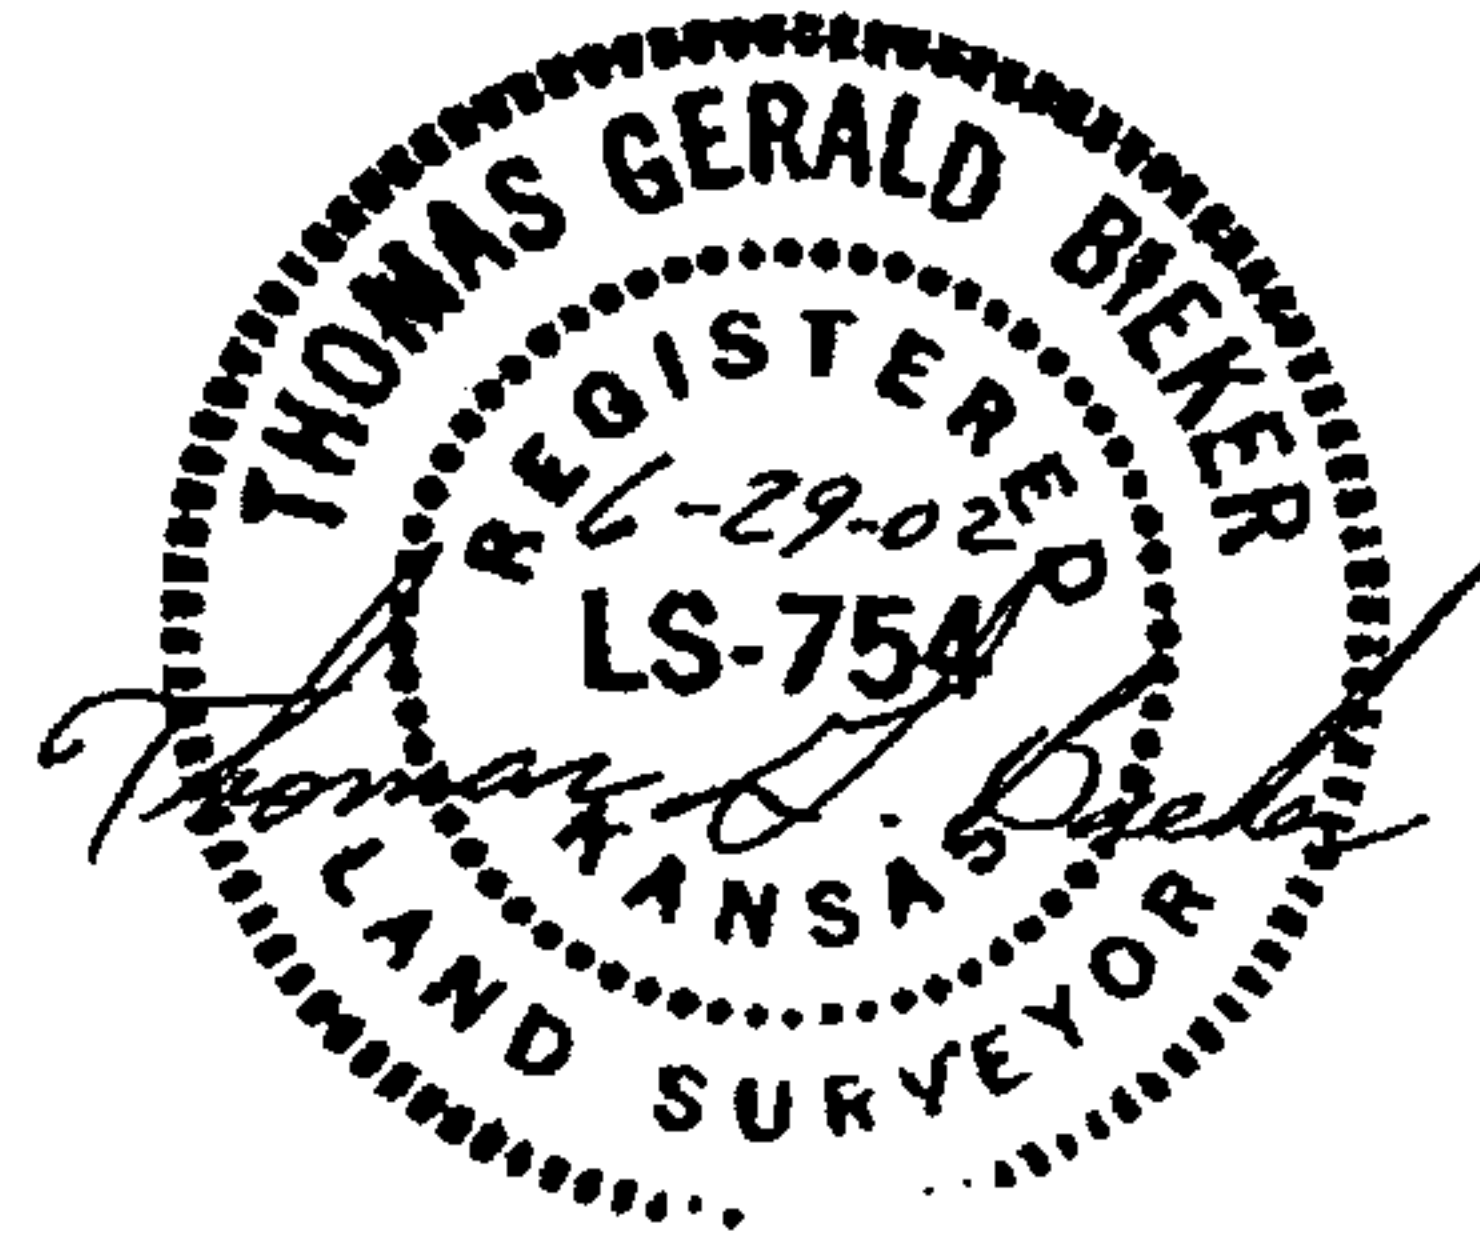

Wells were surveyed using existing control point on site.

	NORTH	WEST	LATITUDE D-M-S	LONGITUDE D-M-S	ELEVATION
SE Corner 20-19-13	00.00	00.00	38-22-35	98-46-28	
Control Point SE-SE-SE-SE	69.33	71.85	38-22-35	98-46-29	1852.16 BOLT <i>(38,76666 - 98,774722 NAD83)</i>
MW SVE-2 SE-SE-SE-SE	124.61	126.32	38-22-36	98-46-29	1852.00 HOLE 1851.60 TOC
MW AS-1 SE-SE-SE-SE	112.76	113.92	38-22-36	98-46-29	1852.24 HOLE 1851.69 TOC
MW SVE-1 SE-SE-SE-SE	105.50	122.55	38-22-36	98-46-29	1852.22 HOLE 1851.86 TOC
MW AS-2 SE-SE-SE-SE	113.63	133.73	38-22-36	98-46-29	1852.11 HOLE 1851.52 TOC
MW 21 SEC 21, T13S, R19W SW-SW-SW -SW	67.59	-25.34	38-22-35	98-46-27	1851.45 HOLE 1850.92 TOC

Note: MW 21 falls in Section 21-19-13 with Northing and Westing relative to this site.
Westing is therefore a negative number. All other wells are in Sec. 20, T19S,
R13W.

HOLE elevation is a 3/16 hole drilled in North side of monitor well rim.