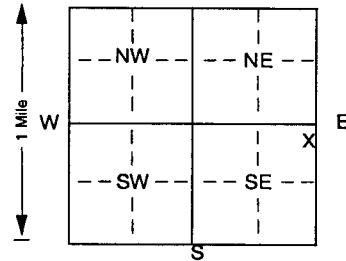


1 LOCATION OF WATER WELL:		Fraction		Section Number		Township Number		Range Number	
County: Barton		NE 1/4 NE 1/4 SE 1/4		30		T 19 S		R 13 E (W)	

Distance and direction from nearest town or city street address of well if located within city?

At 4101 17th St. Terrace, Great Bend

2 WATER WELL OWNER:		Hugh Mauch		Board of Agriculture, Division of Water Resources	
RR#, St. Address, Box #		: 4101 17th St. Terrace		Application Number:	
City, State, ZIP Code		Great Bend, KS 67530			

3 LOCATE WELL'S LOCATION WITH AN "X" IN SECTION BOX:		4 DEPTH OF COMPLETED WELL		61 ft. ELEVATION: unknown	
		Depth(s) Groundwater Encountered 1 ft. 2 ft. 3 ft. ft.			
		WELL'S STATIC WATER LEVEL 14.89 ft. below land surface measured on mo/day/yr 8-1-03			
		Pump test data: Well water was not checked ft. after hours pumping gpm			
		Est. Yield unknown gpm: Well water was ft. after hours pumping gpm			
		Bore Hole Diameter 8 in. to 62 ft., and in. to ft.			
WELL WATER TO BE USED AS:		5 Public water supply 8 Air conditioning 11 Injection well			
1 Domestic 3 Feedlot 6 Oil field water supply 9 Dewatering 12 Other (specify below)					
2 Irrigation 4 Industrial (7) Domestic (lawn & garden) 10 Monitoring well					
Was a chemical/bacteriological sample submitted to Department? Yes No (checked) If yes, mo/day/yr sample was submitted		Water Well Disinfected? Yes No (checked)			

5 TYPE OF BLANK CASING USED:		5 Wrought iron 8 Concrete tile		CASING JOINTS: Glued (checked) Clamped	
1 Steel 3 RMP (SR)		6 Asbestos-Cement 9 Other (specify below)		Welded	
(2) PVC 4 ABS		7 Fiberglass		Threaded	
Blank casing diameter 5 in. to 49 ft., Dia		in. to ft., Dia		in. to ft.	
Casing height above land surface 24 in., weight 2.36		lbs./ft. Wall thickness or gauge No .214			
TYPE OF SCREEN OR PERFORATION MATERIAL:		(7) PVC		10 Asbestos-cement	
1 Steel 3 Stainless steel 5 Fiberglass 8 RMP (SR)		11 Other (specify)		12 None used (open hole)	
2 Brass 4 Galvanized steel 6 Concrete tile 9 ABS					
SCREEN OR PERFORATION OPENINGS ARE:		5 Gauzed wrapped 8 Saw cut 11 None (open hole)			
1 Continuous slot (3) Mill slot 6 Wire wrapped 9 Drilled holes		10 Other (specify)		ft.	
2 Louvered shutter 4 Key punched 7 Torch cut				ft.	
SCREEN-PERFORATED INTERVALS: From 49 ft. to 59 ft., From ft. to ft.				ft.	
GRAVEL PACK INTERVALS: From 43 ft. to 65 ft., From ft. to ft.				ft.	
				ft.	

6 GROUT MATERIAL:		1 Neat cement 2 Cement grout 3 Bentonite 4 Other Bentonite Holeplug	
Sand			
Grout Intervals: From 25 ft. to 39 ft., From 0 ft. to 25 ft., From 39 ft. to 43 ft.			
What is the nearest source of possible contamination:		10 Livestock pens 14 Abandoned water well	
1 Septic tank 4 Lateral lines 7 Pit privy 11 Fuel storage 15 Oil well/Gas well		16 Other (specify below)	
2 Sewer lines 5 Cess pool 8 Sewage lagoon 12 Fertilizer storage		None known	
3 Watertight sewer lines 6 Seepage pit 9 Feedyard 13 Insecticide storage			
Direction from well?		How many feet?	

FROM	TO	LITHOLOGIC LOG	FROM	TO	PLUGGING INTERVALS
0	2	Topsoil			
2	24	Sand, coarse to fine			
24	25	Clay, black			
25	35	Sand and gravel, medium to fine			
35	39	Clay, tan			
39	40	Sand and gravel, medium to fine			
40	43	Clay, tan			
43	59	Sand and gravel, medium to fine			
59	60	Clay, tan			
60	62	Sand and gravel, medium to fine			

7 CONTRACTOR'S OR LANDOWNER'S CERTIFICATION: This water well was (1) constructed (2) reconstructed or (3) plugged under my jurisdiction and was completed on (mo/day/year) 8-1-03 and this record is true to the best of my knowledge and belief. Kansas Water Well Contractor's License No 185 This Water Well Record was completed on (mo/day/yr) 8-4-03 under the business name of Clarke Well & Equipment, Inc. by (signature)	
INSTRUCTIONS: Use typewriter or ball point pen. PLEASE PRESS FIRMLY and PRINT clearly. Please fill in blanks, underline or circle the correct answers. Send top three copies to Kansas Department of Health and Environment, Bureau of Water, Topeka, Kansas 66620-0001. Telephone 785-296-5524. Send one to WATER WELL OWNER and retain one for your records. Fee of \$5.00 for each constructed well.	