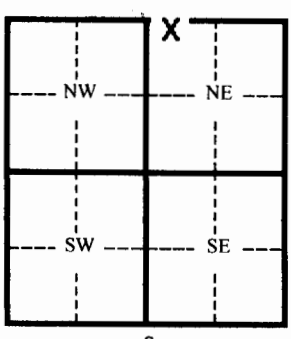


WATER WELL PLUGGING RECORD

FORM WWC-5P

KSA 82a-1212

1 LOCATION OF WATER WELL:		Fraction	Section Number	Township Number	Range Number																																
County: Barton		NW ¼ NW ¼ NE ¼	32	19	13																																
Distance and direction from nearest town or city street address of well if located within city?																																					
2 WATER WELL OWNER: Loves Country Store																																					
RR#, St. Address, Box # P. O. Box 26210																																					
City, State, ZIP Code : Oklahoma City, Ok			PMW - 6	Board of Agriculture, Division of Water Resources																																	
			Application Number:																																		
3 MARK WELL'S LOCATION WITH AN "X" IN SECTION BOX:		4 DEPTH OF WELL 15 ft.																																			
		WELL'S STATIC WATER LEVEL _____ ft.																																			
		WELL WAS USED AS:																																			
		1 Domestic 5 Public Water Supply 9 Dewatering 2 Irrigation 6 Oil Field Water Supply 10 Monitoring Well 3 Feedlot 7 Lawn and Garden (domestic) 11 Injection Well 4 Industrial 8 Air Conditioning 12 Other _____																																			
		Was a chemical/bacteriological sample submitted to Department? Yes _____ No X If yes, mo/day/yr sample was submitted _____ Water Well Disinfected: Yes _____ No X																																			
5 TYPE OF BLANK CASING USED:																																					
1 Steel 3 RMP (SR) 5 Wrought 7 Fiberglass 9 Other (specify below) 2 PVC 4 ABC 6 Asbestos-Cement 8 Concrete Tile																																					
Blank casing diameter 2 in. Was casing pulled? Yes X No _____ If yes, how much _____																																					
Casing height above or below land surface 0 in.																																					
6 GROUT PLUG MATERIAL: 1 Neat cement 2 Cement grout 3 Bentonite 4 Other _____																																					
Grout Plug Intervals From _____ ft. to _____ ft. From _____ ft. to _____ ft. From _____ ft. to _____ ft.																																					
What is the nearest source of possible contamination:																																					
1 Septic tank 6 Seepage pit 11 Fuel storage 16 Other (specify below) 2 Sewer lines 7 Pit privy 12 Fertilizer storage 3 Watertight sewer lines 8 Sewage lagoon 13 Insecticide storage 4 Lateral lines 9 Feedyard 14 Abandoned water well 5 Cess Pool 10 Livestock pens 15 Oil well/ Gas well																																					
Direction from well? _____ How many feet? _____																																					
<table border="1" style="width:100%; border-collapse: collapse;"> <thead> <tr> <th style="width:10%;">FROM</th> <th style="width:10%;">TO</th> <th style="width:10%;">CODE</th> <th style="width:70%;">PLUGGING MATERIALS</th> </tr> </thead> <tbody> <tr> <td>15</td> <td>0</td> <td></td> <td>Hole Plug</td> </tr> <tr><td> </td><td> </td><td> </td><td> </td></tr> <tr><td> </td><td> </td><td> </td><td> </td></tr> <tr><td> </td><td> </td><td> </td><td> </td></tr> <tr><td> </td><td> </td><td> </td><td> </td></tr> <tr><td> </td><td> </td><td> </td><td> </td></tr> <tr><td> </td><td> </td><td> </td><td> </td></tr> </tbody> </table>						FROM	TO	CODE	PLUGGING MATERIALS	15	0		Hole Plug																								
FROM	TO	CODE	PLUGGING MATERIALS																																		
15	0		Hole Plug																																		
7 CONTRACTOR'S OR LANDOWNER'S CERTIFICATION: This water well was plugged under my jurisdiction and was completed on (mo/day/yr) 8-2-04 and this record is true to the best of my knowledge and belief. Kansas Water Well Contractor's License No. 554 This Water Well Record was completed on (mo/day/yr) 8-24-04 under the business name of Woofor Pump & Well, Inc. by (signature) <i>Jay C. Woofor</i>																																					
INSTRUCTIONS: Please fill in blanks and circle the correct answers. Send three copies to Kansas Department of Health and Environment, Bureau of Water, Topeka, Kansas 66620-0001. Telephone: 785-296-3565. Send one to Water Well Owner and retain one for your records.																																					

RECEIVED

SEP 15 2004

BUREAU OF WATER