


1	LOCATION OF WATER WELL:	Fraction	Section Number	Township Number	Range Number
County:	<u>Barton</u>	<u>NW 1/4 NE 1/4 NE 1/4</u>	<u>32</u>	T <u>19</u> S	R <u>13</u> E <u>W</u>

2823 10th Street, Great Bend, KS

RR#, St. Address, Box # : 2617 N. Broadway
City, State, ZIP Code : Wichita, KS 67219

3 LOCATE WELL'S LOCATION WITH 4 DEPTH OF COMPLETED WELL 25 ft. ELEVATION: 1850.60

4 DEPTH OF COMPLETED WELL: 25 ft. ELEVATION: 1850.660
Depth(s) Groundwater Encountered: 1. ~13 ft. 2. _____ ft. 3. _____ ft.

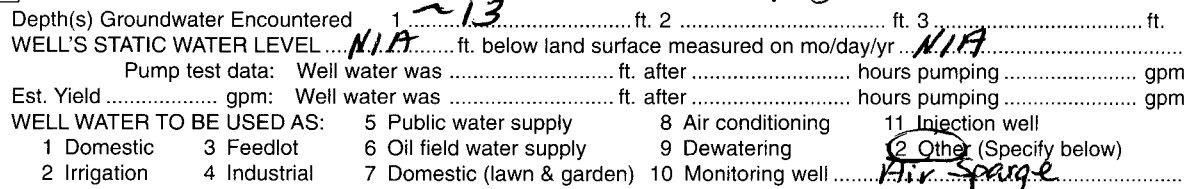

5 Wrought iron	8 Concrete tile	CASING JOINTS: Glued	Clamped
6 Asbestos-Cement	9 Other (specify below)	Welded	
7 Fiberglass		Threaded X	

Blank casing diameter 2 1/2 in. to 25 ft. Dia _____ in. to _____ ft. Dia _____ in. to _____ ft.
Casing height above land surface - 6 in., weight _____ lbs./ft. Wall thickness or gauge No. Sch 40 PK

5 Fiberglass 7 PVC 10 Asbestos-Cement
6 Concrete tile 8 RMP (SR) 11 Other (Specify)
 9 ABS 12 None used (open hole)

5 Guazed wrapped 8 Saw cut 11 None (open hole)
6 Wire wrapped 9 Drilled holes
7 Torch cut 10 Other (specify)ft.

SCREEN-PERFORATED INTERVALS: From 22.5 ft. to 25 ft., From _____ ft. to _____ ft.
From _____ ft. to _____ ft., From _____ ft. to _____ ft.
GRAVEL PACK INTERVALS: From 9 ft. to 25 ft., From _____ ft. to _____ ft.
From _____ ft. to _____ ft., From _____ ft. to _____ ft.

6 GROUT MATERIAL: 1 Neat cement 2 Cement grout 3 Bentonite 4 Other.....
Grout Intervals: From ~~2~~ 3 ft. to 9 ft. From ft. to ft. From ft. to ft.

What is the nearest source of possible contamination:

1 Septic tank	4 Lateral lines	7 Pit privy	10 Livestock pens	14 Abandoned water well
2 Sewer lines	5 Cess pool	8 Sewage lagoon	11 Fuel storage	15 Oil well/Gas well
3 Watertight sewer lines	6 Seepage pit	9 Feedyard	12 Fertilizer storage	16 Other (specify below)

Direction from well? _____

How many feet? _____

Last Site

[illegible]

7 CONTRACTOR'S OR LANDOWNER'S CERTIFICATION: This water well was (1) constructed, (2) reconstructed, or (3) plugged under my jurisdiction and was completed on (mo/day/year) 11/15/04 and this record is true to the best of my knowledge and belief. Kansas Water Well Contractor's Licence No. 394 This Water Well Record was completed on (mo/day/yr) 3/15/05 under the business name of Carrapetore of Opaire Tex by (signature) [Signature]

INSTRUCTIONS: Use typewriter or ball point pen. PLEASE PRESS FIRMLY and PRINT clearly. Please fill in blanks, underline or circle the correct answers. Send top three copies to Kansas Department of Health and Environment, Bureau of Water, Geology Section, 1000 SW Jackson St., Suite 420, Topeka, Kansas 66612-1367. Telephone 785-296-5522. Send one to WATER WELL OWNER and retain one for your records. Fee of \$5.00 for each constructed well.