

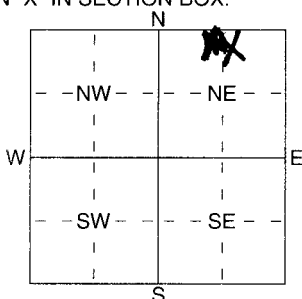
1 LOCATION OF WATER WELL: County: <u>Barton</u> Fraction: <u>NW 1/4 NE 1/4 NE 1/4</u> Section Number: <u>32</u> Township Number: <u>T 19 S</u> Range Number: <u>R 13 EW</u>

Distance and direction from nearest town or city street address of well if located within city?

2823 10th Street, Great Bend, KS2 WATER WELL OWNER: Klepper oil Co.RR#, St. Address, Box # : 2617 N. Broadway
City, State, ZIP Code : Wichita, KS 67219

Board of Agriculture, Division of Water Resources

Application Number:

3 LOCATE WELL'S LOCATION WITH AN "X" IN SECTION BOX: 4 DEPTH OF COMPLETED WELL 25 ft. ELEVATION: 1850.76 ft.Depth(s) Groundwater Encountered N/A ~ 13 ft. 2 ft. 3 ft.WELL'S STATIC WATER LEVEL N/A ft. below land surface measured on mo/day/yr N/A ft.

Pump test data: Well water was ft. after hours pumping gpm

Est. Yield gpm: Well water was ft. after hours pumping gpm

WELL WATER TO BE USED AS: 5 Public water supply 8 Air conditioning 11 Injection well

1 Domestic 3 Feedlot 6 Oil field water supply 9 Dewatering 12 Other (Specify below)

2 Irrigation 4 Industrial 7 Domestic (lawn & garden) 10 Monitoring well Air SpargeWas a chemical/bacteriological sample submitted to Department? Yes No X; If yes, mo/day/yr sample was submitted Water Well Disinfected? Yes No X

5 TYPE OF BLANK CASING USED: 1 Steel 3 RMP (SR) 5 Wrought iron 8 Concrete tile CASING JOINTS: Glued Clamped

2 PVC 4 ABS 6 Asbestos-Cement 9 Other (specify below) Welded Threaded XBlank casing diameter 2 in. to 25 ft., Dia in. to ft., Dia in. to ft.Casing height above land surface 3.96 in., weight lbs./ft. Wall thickness or guage No. Sch 40 PVC

TYPE OF SCREEN OR PERFORATION MATERIAL:

1 Steel 3 Stainless Steel 5 Fiberglass 8 RMP (SR) 10 Asbestos-Cement

2 Brass 4 Galvanized Steel 6 Concrete tile 9 ABS 11 Other (Specify) 12 None used (open hole)

SCREEN OR PERFORATION OPENINGS ARE:

1 Continuous slot 3 Mill slot 5 Guazed wrapped 8 Saw cut 11 None (open hole)

2 Louvered shutter 4 Key punched 6 Wire wrapped 9 Drilled holes

SCREEN-PERFORATED INTERVALS: From 22.5 ft. to 25 ft., From ft. to ft.

From ft. to ft., From ft. to ft.

GRAVEL PACK INTERVALS: From 10 ft. to 25 ft., From ft. to ft.

From ft. to ft., From ft. to ft.

6 GROUT MATERIAL: 1 Neat cement 2 Cement grout 3 Bentonite 4 OtherGrout Intervals: From 3 ft. to 10 ft., From ft. to ft., From ft. to ft.

What is the nearest source of possible contamination:

1 Septic tank 4 Lateral lines 7 Pit privy 10 Livestock pens 14 Abandoned water well

2 Sewer lines 5 Cess pool 8 Sewage lagoon 11 Fuel storage 15 Oil well/Gas well

3 Watertight sewer lines 6 Seepage pit 9 Feedyard 12 Fertilizer storage 16 Other (specify below)

Direction from well? How many feet? East site

FROM TO LITHOLOGIC LOG FROM TO PLUGGING INTERVALS

0 4 Fill4 10 White rock10 13 Sand, medium grained, high odor13 25 Sand, medium to gravel, high odor7 CONTRACTOR'S OR LANDOWNER'S CERTIFICATION: This water well was (1) constructed (2) reconstructed, or (3) plugged under my jurisdiction and was completed on (mo/day/year) 11/15/04 and this record is true to the best of my knowledge and belief. Kansas Water Well Contractor's Licence No 514 This Water Well Record was completed on (mo/day/yr) 3/15/05 under the business name of Coranco Great Plains, Inc. by (signature) Michael E. Green