WATER WELL RECORD Form WWC-5 KSA 82a-1212 ID No. _____

1 LOCATION OF WATER WELL: County: Barton | Fraction: SW ¼ SW ¼ SW ¼ | Section Number: 29 | Township Number: T 19 S | Range Number: R 13 E (W)

Distance and direction from nearest town or city street address of well if located within city?
Walgreen's Parking Lot Corner of McKinley St. and Highway 56

2 WATER WELL OWNER: J Paul Properties Management
RR#, St. Address, Box # : PO Box 5318
City, State, ZIP Code : Topeka KS 66605
Board of Agriculture, Division of Water Resources Application Number:

3 LOCATE WELL'S LOCATION WITH AN "X" IN SECTION BOX:

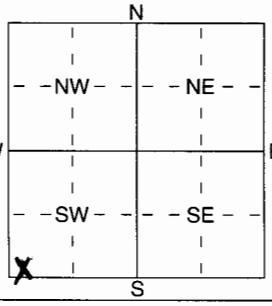

4 DEPTH OF COMPLETED WELL 25 ft. ELEVATION:
Depth(s) Groundwater Encountered 1 18 ft. 2 — ft. 3 — ft.
WELL'S STATIC WATER LEVEL 18 ft. below land surface measured on mo/day/yr 3-15-05
Pump test data: Well water was — ft. after — hours pumping — gpm
Est. Yield — gpm: Well water was — ft. after — hours pumping — gpm
WELL WATER TO BE USED AS: 1 Domestic 2 Irrigation 3 Feedlot 4 Industrial 5 Public water supply 6 Oil field water supply 7 Domestic (lawn & garden) 8 Air conditioning 9 Dewatering (10) Monitoring well 11 Injection well 12 Other (Specify below)

Was a chemical/bacteriological sample submitted to Department? Yes ..... No X; If yes, mo/day/yrs sample was submitted
Water Well Disinfected? Yes No X

5 TYPE OF BLANK CASING USED: (2) PVC | 1 Steel | 3 RMP (SR) | 4 ABS | 5 Wrought iron | 6 Asbestos-Cement | 7 Fiberglass | 8 Concrete tile | 9 Other (specify below)
CASING JOINTS: Glued ..... Clamped ..... Welded ..... Threaded X
Blank casing diameter 1 in. to Flushmount ft., Dia — in. to — ft., Dia — in. to — ft.
Casing height above land surface Flushmount in., weight — lbs./ft. Wall thickness or guage No. —

TYPE OF SCREEN OR PERFORATION MATERIAL: (7) PVC | 1 Steel | 2 Brass | 3 Stainless Steel | 4 Galvanized Steel | 5 Fiberglass | 6 Concrete tile | 8 RMP (SR) | 9 ABS | 10 Asbestos-Cement | 11 Other (Specify) | 12 None used (open hole)

SCREEN OR PERFORATION OPENINGS ARE: (3) Mill slot | 1 Continuous slot | 2 Louvered shutter | 4 Key punched | 5 Guazed wrapped | 6 Wire wrapped | 7 Torch cut | 8 Saw cut | 9 Drilled holes | 10 Other (specify) | 11 None (open hole)

SCREEN-PERFORATED INTERVALS: From 25 ft. to 10 ft., From — ft. to — ft.
From — ft. to — ft., From — ft. to — ft.
GRAVEL PACK INTERVALS: From 25 ft. to 8 ft., From — ft. to — ft.
From — ft. to — ft., From — ft. to — ft.

6 GROUT MATERIAL: 1 Neat cement | 2 Cement grout | (3) Bentonite | 4 Other
Grout Intervals: From 8 ft. to 2 ft., From — ft. to — ft., From — ft. to — ft.

What is the nearest source of possible contamination:
1 Septic tank | 2 Sewer lines | 3 Watertight sewer lines | 4 Lateral lines | 5 Cess pool | 6 Seepage pit | 7 Pit privy | 8 Sewage lagoon | 9 Feedyard | 10 Livestock pens | 11 Fuel storage | 12 Fertilizer storage | 13 Insecticide storage | 14 Abandoned water well | 15 Oil well/Gas well | (16) Other (specify below) former Gas Station
Direction from well? How many feet?

FROM	TO	LITHOLOGIC LOG	FROM	TO	PLUGGING INTERVALS
0	1	Asphalt over gravel			
1	4	Silty clay dark brown Soft moist			
4	7	fine grain sand moist			
7	14	Med to coarse grain sand poorly sorted			
14	25	Loose grain sand with gravel poorly sorted			

7 CONTRACTOR'S OR LANDOWNER'S CERTIFICATION: This water well was (1) constructed, (2) reconstructed, or (3) plugged under my jurisdiction and was completed on (mo/day/year) 3.15.05 and this record is true to the best of my knowledge and belief. Kansas Water Well Contractor's Licence No 710 This Water Well Record was completed on (mo/day/yr) 4.05.06 under the business name of Below Ground Surface, Inc. by (signature)

INSTRUCTIONS: Use typewriter or ball point pen. *PLEASE PRESS FIRMLY* and *PRINT* clearly. Please fill in blanks, underline or circle the correct answers. Send top three copies to Kansas Department of Health and Environment, Bureau of Water, Geology Section, 1000 SW Jackson St., Suite 420, Topeka, Kansas 66612-1367. Telephone 785-296-5522. Send one to WATER WELL OWNER and retain one for your records. Fee of $5.00 for each constructed well.