

1 LOCATION OF WELL:	Fraction	Section Number	Township Number	Range Number
County: Barton	SE 1/4 SW 1/4 SW 1/4	27	19	13 W

Distance and direction from nearest town or city street address of well if located within city?

35' S, 24' E of SW corner of truck repair building; 624 E. 10th St.

2 WATER WELL OWNER:	Dorothy Morrison c/o Glen Opie	Board of Agriculture, Division of Water Resources
RR#, St. Address, Box #	PO Drawer E	Application Number:
City, State, ZIP Code :	Great Bend, KS 67530	

3 MARK WELL'S LOCATION WITH AN "X" IN SECTION BOX:

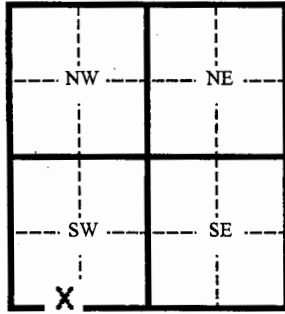
4 DEPTH OF WELL **13.91** ft. Originally drilled to 13.5 ft bgs.WELL'S STATIC WATER LEVEL **9.35** ft.

WELL WAS USED AS:

- | | | |
|--------------|------------------------------|---------------------------|
| 1 Domestic | 5 Public Water Supply | 9 Dewatering |
| 2 Irrigation | 6 Oil Field Water Supply | 10 Monitoring Well |
| 3 Feedlot | 7 Lawn and Garden (domestic) | 11 Injection Well |
| 4 Industrial | 8 Air Conditioning | 12 Other |

Was a chemical/bacteriological sample submitted to Department? Yes ___ No **X**

If yes, mo/day/yr sample was submitted _____

Water Well Disinfected: Yes ___ No **X**

5 TYPE OF BLANK CASING USED:

- | | | | | |
|--------------|------------|-------------------|-----------------|-------------------------|
| 1 Steel | 3 RMP (SR) | 5 Wrought | 7 Fiberglass | 9 Other (specify below) |
| 2 PVC | 4 ABC | 6 Asbestos-Cement | 8 Concrete Tile | |

Blank casing diameter **2** in. Was casing pulled? Yes ___ No **X** If yes, how much _____Casing height above or **below** land surface **0** in. **Overdrilled to 15 feet below ground surface**6 GROUT PLUG MATERIAL: 1 Neat cement 2 Cement grout **3 Bentonite** 4 Other _____Grout Plug Intervals From **3** ft. to **15** ft. From _____ ft. to _____ ft. From _____ ft. to _____ ft.

What is the nearest source of possible contamination:

- | | | | |
|--------------------------|-------------------|-------------------------|--------------------------|
| 1 Septic tank | 6 Seepage pit | 11 Fuel storage | 16 Other (specify below) |
| 2 Sewer lines | 7 Pit privy | 12 Fertilizer storage | |
| 3 Watertight sewer lines | 8 Sewage lagoon | 13 Insecticide storage | |
| 4 Lateral lines | 9 Feedyard | 14 Abandoned water well | |
| 5 Cess Pool | 10 Livestock pens | 15 Oil well/ Gas well | |

Direction from well? _____

How many feet? _____

FROM	TO	CODE	PLUGGING MATERIALS
0	3		Rock
3	15		Bentonite 200 lbs.

7	CONTRACTOR'S OR LANDOWNER'S CERTIFICATION: This water well was plugged under my jurisdiction and was completed on (mo/day/yr) 6-28-05 and this record is true to the best of my knowledge and belief. Kansas Water Well Contractor's License No. 531 This Water Well Record was completed on (mo/day/yr) 7-12-05 under the business name of Geotechnical Service, Inc. by (signature) <i>[Signature]</i>
---	--

INSTRUCTIONS: Please fill in blanks and circle the correct answers. Send three copies to Kansas Department of Health and Environment, Bureau of Water, 1000 S W Jackson St., Ste. 420, Topeka, Kansas 66620-0001. Telephone: 785-296-3565. Send one to Water Well Owner and retain one for your records.