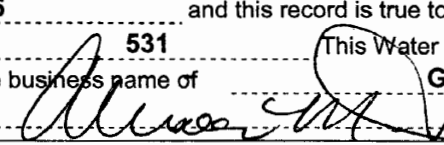


WATER WELL PLUGGING RECORD

Form WWC-5P

KSA 82a-1212

ID No. 00162540

1 LOCATION OF WATER WELL:		Fraction	Section Number	Township Number	Range Number																
County: Barton		NW 1/4 NE 1/4 NE 1/4	33	19	13 W																
Distance and direction from nearest town or city street address of well if located within city? 1601 10th Street, Great Bend																					
2 WATER WELL OWNER:		Valero Energy Corporation																			
RR#, St. Address, Box #		5590 Havana Street, Bldg B																			
City, State, ZIP Code :		Denver, CO 80239																			
		Board of Agriculture, Division of Water Resources																			
		Application Number:																			
3 MARK WELL'S LOCATION WITH AN "X" IN SECTION BOX:		4 DEPTH OF WELL 13.74 ft. Originally drilled to 15 ft. bgs.																			
N <table border="1" style="margin: auto; border-collapse: collapse;"><tr><td></td><td></td><td></td><td>X</td></tr><tr><td>NW</td><td></td><td>NE</td><td></td></tr><tr><td></td><td></td><td></td><td></td></tr><tr><td>SW</td><td></td><td>SE</td><td></td></tr></table> S WE					X	NW		NE						SW		SE		WELL'S STATIC WATER LEVEL 10.01 ft.			
					X																
		NW		NE																	
SW		SE																			
WELL WAS USED AS:																					
1 Domestic 5 Public Water Supply 9 Dewatering																					
2 Irrigation 6 Oil Field Water Supply 10 Monitoring Well																					
3 Feedlot 7 Lawn and Garden (domestic) 11 Injection Well																					
4 Industrial 8 Air Conditioning 12 Other																					
Was a chemical/bacteriological sample submitted to Department? Yes No X																					
If yes, mo/day/yr sample was submitted																					
Water Well Disinfected: Yes No X																					
5 TYPE OF BLANK CASING USED:																					
1 Steel 3 RMP (SR) 5 Wrought 7 Fiberglass 9 Other (specify below)																					
2 PVC 4 ABC 6 Asbestos-Cement 8 Concrete Tile																					
Blank casing diameter 2 in. Was casing pulled? Yes X No If yes, how much 13.74 ft.																					
Casing height above or below land surface 0.0 in. Overdrilled to 14 ft below ground surface																					
6 GROUT PLUG MATERIAL: 1 Neat cement 2 Cement grout 3 Bentonite 4 Other																					
Grout Plug Intervals From 3 ft. to 9.5 ft. From ft. to ft. From ft. to ft.																					
What is the nearest source of possible contamination:																					
1 Septic tank 6 Seepage pit 11 Fuel storage 16 Other (specify below)																					
2 Sewer lines 7 Pit privy 12 Fertilizer storage																					
3 Watertight sewer lines 8 Sewage lagoon 13 Insecticide storage																					
4 Lateral lines 9 Feedyard 14 Abandoned water well																					
5 Cess Pool 10 Livestock pens 15 Oil well/ Gas well																					
Direction from well? How many feet?																					
FROM	TO	CODE	PLUGGING MATERIALS																		
0	3		Soil																		
3	9.5		Bentonite																		
9.5	14		Native Soil - boring caved																		
7 CONTRACTOR'S OR LANDOWNER'S CERTIFICATION: This water well was plugged under my jurisdiction and was completed on (mo/day/yr) 8-4-05 and this record is true to the best of my knowledge and belief. Kansas Water Well Contractor's License No. 531 (This Water Well Record was completed on (mo/day/yr) 8-29-05 under the business name of Geotechnical Services, Inc. by (signature) 																					
INSTRUCTIONS: Please fill in blanks and circle the correct answers. Send three copies to Kansas Department of Health and Environment, Bureau of Water, 1000 S W Jackson St., Ste. 420, Topeka, Kansas 66620-0001. Telephone: 785-296-3565. Send one to Water Well Owner and retain one for your records.																					