

1	LOCATION OF WATER WELL:	Fraction	Section Number	Township Number	Range Number
County:	Barton	SE ¼ SE ¼ SW ¼	29	T 19 S	R 13w E/W

Distance and direction from nearest town or city street address of well if located within city?

downtown Great Bend, KS

2	WATER WELL OWNER: Sunflower Bank
---	----------------------------------

BB# St Address Box # 1901 12th St.

City, State, ZIP Code : Great Bend, KS 67530


Board of Agriculture, Division of Water Resources

Application Number:

3	LOCATE WELL'S LOCATION WITH
---	-----------------------------

4 DEPTH OF COMPLETED WELL 65 ft. ELEVATION: ... unknown

AN "X" IN SECTION BOX:

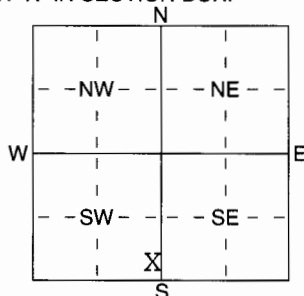

Depth(s) Groundwater Encountered 1 18 ft. 2 _____ ft. 3 _____ ft.

WELL'S STATIC WATER LEVEL 18 ft. below land surface measured on mo/day/yr 09/02/05

Pump test data: Well water was ft. after hours pumping gpm

Est. Yield 70 gpm: Well water was ft. after hours pumping gpm

WELL WATER TO BE USED AS: 5 Public water supply 8 Air conditioning 11 Injection well

1 Domestic 3 Feedlot 6 Oil field water supply 9 Dewatering 12 Other (Specify below)

2 Irrigation 4 Industrial 7 Domestic (lawn & garden) 10 Monitoring well

Was a chemical/bacteriological sample submitted to Department? Yes No ; If yes, mo/day/yr sample was submitted

Water Well Disinfected? Yes No

Water Well Disinfected? Yes No

5	TYPE OF BLANK CASING USED:
---	----------------------------

1 Steel	3 RMP (SR)
<u>2 PVC</u>	4 ABS

Blank casing diameter 5 in. to 50 ft. Dia in. to ft. Dia in. to ft.

Casing height above land surface 12 in., weight 2.8 lbs./ft. Wall thickness or gauge No. Sch. 40

TYPE OF SCREEN OR PERFORATION MATERIAL:

1 Steel	3 Stainless Steel	5 Fiberglass	8 RMP (SR)	11 Other (Specify)
2 Brass	4 Galvanized Steel	6 Concrete tile	9 ABS	12 None used (open hole)

SCREEN OR PERFORATION OPENINGS ARE:

1 Continuous slot	3 Mill slot	6 Wire wrapped	9 Drilled holes
2 Louvered shutter	4 Key punched	7 Torch cut	10 Other (specify) ft.

SCREEN-PERFORATED INTERVALS: From 50 ft. to 65 ft. From _____ ft. to _____ ft.

From ft. to ft. From ft. to ft.

GRAVEL PACK INTERVALS: From 23 ft. to 42 ft., From 47 ft. to 65 ft.

From ft. to ft., From ft. to ft.

6	GROUT MATERIAL:	1 Neat cement	2 Cement grout	3 Bentonite	4 Other
---	-----------------	---------------	----------------	-------------	---------------

Grout Intervals: From 0 ft. to 23 ft. From 42 ft. to 47 ft. From _____ ft. to _____ ft.

What is the nearest source of possible contamination:

1 Septic tank	4 Lateral lines	7 Pit privy	11 Fuel storage	15 Oil well/Gas well
2 Sewer lines	5 Cess pool	8 Sewage lagoon	12 Fertilizer storage	16 Other (specify below)
3 Watertight sewer lines	6 Seepage pit	9 Feedyard	13 Insecticide storage	city sewer line

Direction from well West

How many feet? 30

[illegible]

7 CONTRACTOR'S OR LANDOWNER'S CERTIFICATION: This water well was (1) constructed, (2) reconstructed, or (3) plugged under my jurisdiction and was completed on (mo/day/year) 09/02/05 and this record is true to the best of my knowledge and belief. Kansas

Water Well Contractor's Licence No. 186 This Water Well Record was completed on (mo/day/yr) 09/07/05
under the business name of Kelly's Water Well Service, Inc. by (signature) Kathleen L. Wood

INSTRUCTIONS: Use typewriter or ball point pen. PLEASE PRESS FIRMLY and PRINT clearly. Please fill in blanks, underline or circle the correct answers. Send top three copies to Kansas Department of Health and Environment, Bureau of Water, Geology Section, 1000 SW Jackson St., Suite 420, Topeka, Kansas 66612-1367. Telephone 785-296-5522. Send one to WATER WELL OWNER and retain one for your records. Fee of \$5.00 for each constructed well.