

County: Barton Fraction: SE SE SE SE Sec. 20 T. 19 S R. 13 W

CORRECTION(S) to WATER WELL COMPLETION RECORD Form WWC-5 (to rectify lacking or incorrect information)

Owner: Presto 18 AS 1

If location corrected, was listed as:

Section-Township-Range: 21-19-13W

Fraction (1/4 calls): SE SE SE

Location changed to:

20-19-13W

SE SE SE SE

Other changes: Initial statements: Anspaugh Rentals

1123 Washington, Great Bend

Changed to: Presto 18

2401 Washington St, Great Bend Latitude: 38.76666 Longitude -98.774722 Elevation: 1852.24

Comments: _____

Verification method: Per Bieker Surveying record and memorandum from KDHE 12-02-1-2019 used

LEOWEB for Lat/Long

Initials: SH Date: 04-17-2020

Submitted by: ☒ Kansas Geological Survey, Data Resources Library, 1930 Constant Ave., Lawrence, KS 66047-3724

☐ Kansas Dept. of Health & Environment, Bureau of Water, 1000 SW Jackson, Suite 420, Topeka, KS 66612-1367

1	LOCATION OF WATER WELL:	Fraction	Section Number	Township Number	Range Number
County: Barton	SE $\frac{1}{4}$ SE $\frac{1}{4}$ SE $\frac{1}{4}$	21	19S	13	EW

Distance and direction from nearest town or city street address of well if located within city?

Vacant lot at NW corner of 24th and Washington, Great Bend

2	WATER WELL OWNER: Anspaugh Rentals	
	1123 Washington	
	RR #, St. Address, Box #:	Board of Agriculture, Division of Water Resources
	City, State, ZIP Code: Great Bend, KS 67530	Application Number:

3	MARK WELL'S LOCATION WITH AN "X" IN SECTION BOX:	4	DEPTH OF WELL 21.62 ft.
			WELL'S STATIC WATER LEVEL 16.35 ft.
			WELL WAS USED AS:
			1 Domestic 5 Public Water Supply 9 Dewatering 2 Irrigation 6 Oil Field Water Supply 10 Monitoring Well 3 Feedlot 7 Domestic (Lawn & Garden) 11 Injection Well 4 Industrial 8 Air Conditioning 12 Other
			Was a chemical / bacteriological sample submitted to Department? Yes No X
			If yes, mo/day/yr sample was submitted
			Water Well Disinfected: Yes No X

5	TYPE OF BLANK CASING USED:	
	1 Steel 3 RMP (SR) 5 Wrought 7 Fiberglass 9 Other (Specify below) 2 PVC 4 ABS 6 Asbestos-Cement 8 Concrete Tile	
	Blank casing diameter 2 in.	Was casing pulled? Yes X No If yes, how much 21.8
	Casing height above or below land surface 3 in.	


6	GROUT PLUG MATERIAL: 1 Neat cement 2 Cement grout 3 Bentonite 4 Other	
	Grout Plug Intervals: From 22 ft. to 1 ft., From ft. to ft., From to ft.	
	What is the nearest source of possible contamination:	
	1 Septic tank 6 Seepage pit 11 Fuel storage 16 Other (specify below) 2 Sewer lines 7 Pit privy 12 Fertilizer storage 3 Watertight sewer lines 8 Sewage lagoon 13 Insecticide storage 4 Lateral lines 9 Feedyard 14 Abandoned water well 5 Cess pool 10 Livestock pens 15 Oil well/Gas well	
	Direction from well? ... South How many feet? 75	

FROM	TO	PLUGGING MATERIALS
22	1	3/8 Bentonite Chips
1	0	Clay and top soil

AS-1

7	CONTRACTOR'S OF LANDOWNER'S CERTIFICATION: This water well was plugged under my jurisdiction and was completed on (mo/day/year) 1.0-25-05 and this record is true to the best of my knowledge and belief. Kansas Water Well Contractor's License No. 665 This Water Well Record was completed on (mo/day/year) 1.0-26-05 under the business name of Pratt Well Environmental
	by (signature) <i>[Signature]</i>

INSTRUCTIONS: Use typewriter or ball point pen. Please press firmly and print clearly. Please fill in blanks, underline or circle the correct answers. Send top three copies to Kansas Department of Health and Environment, Bureau of Water, Geology Section, 1000 SW Jackson St., Ste. 420, Topeka, Kansas 66612-1367. Telephone: 785/296-5522. Send one to Water Well Owner and retain one for your records.

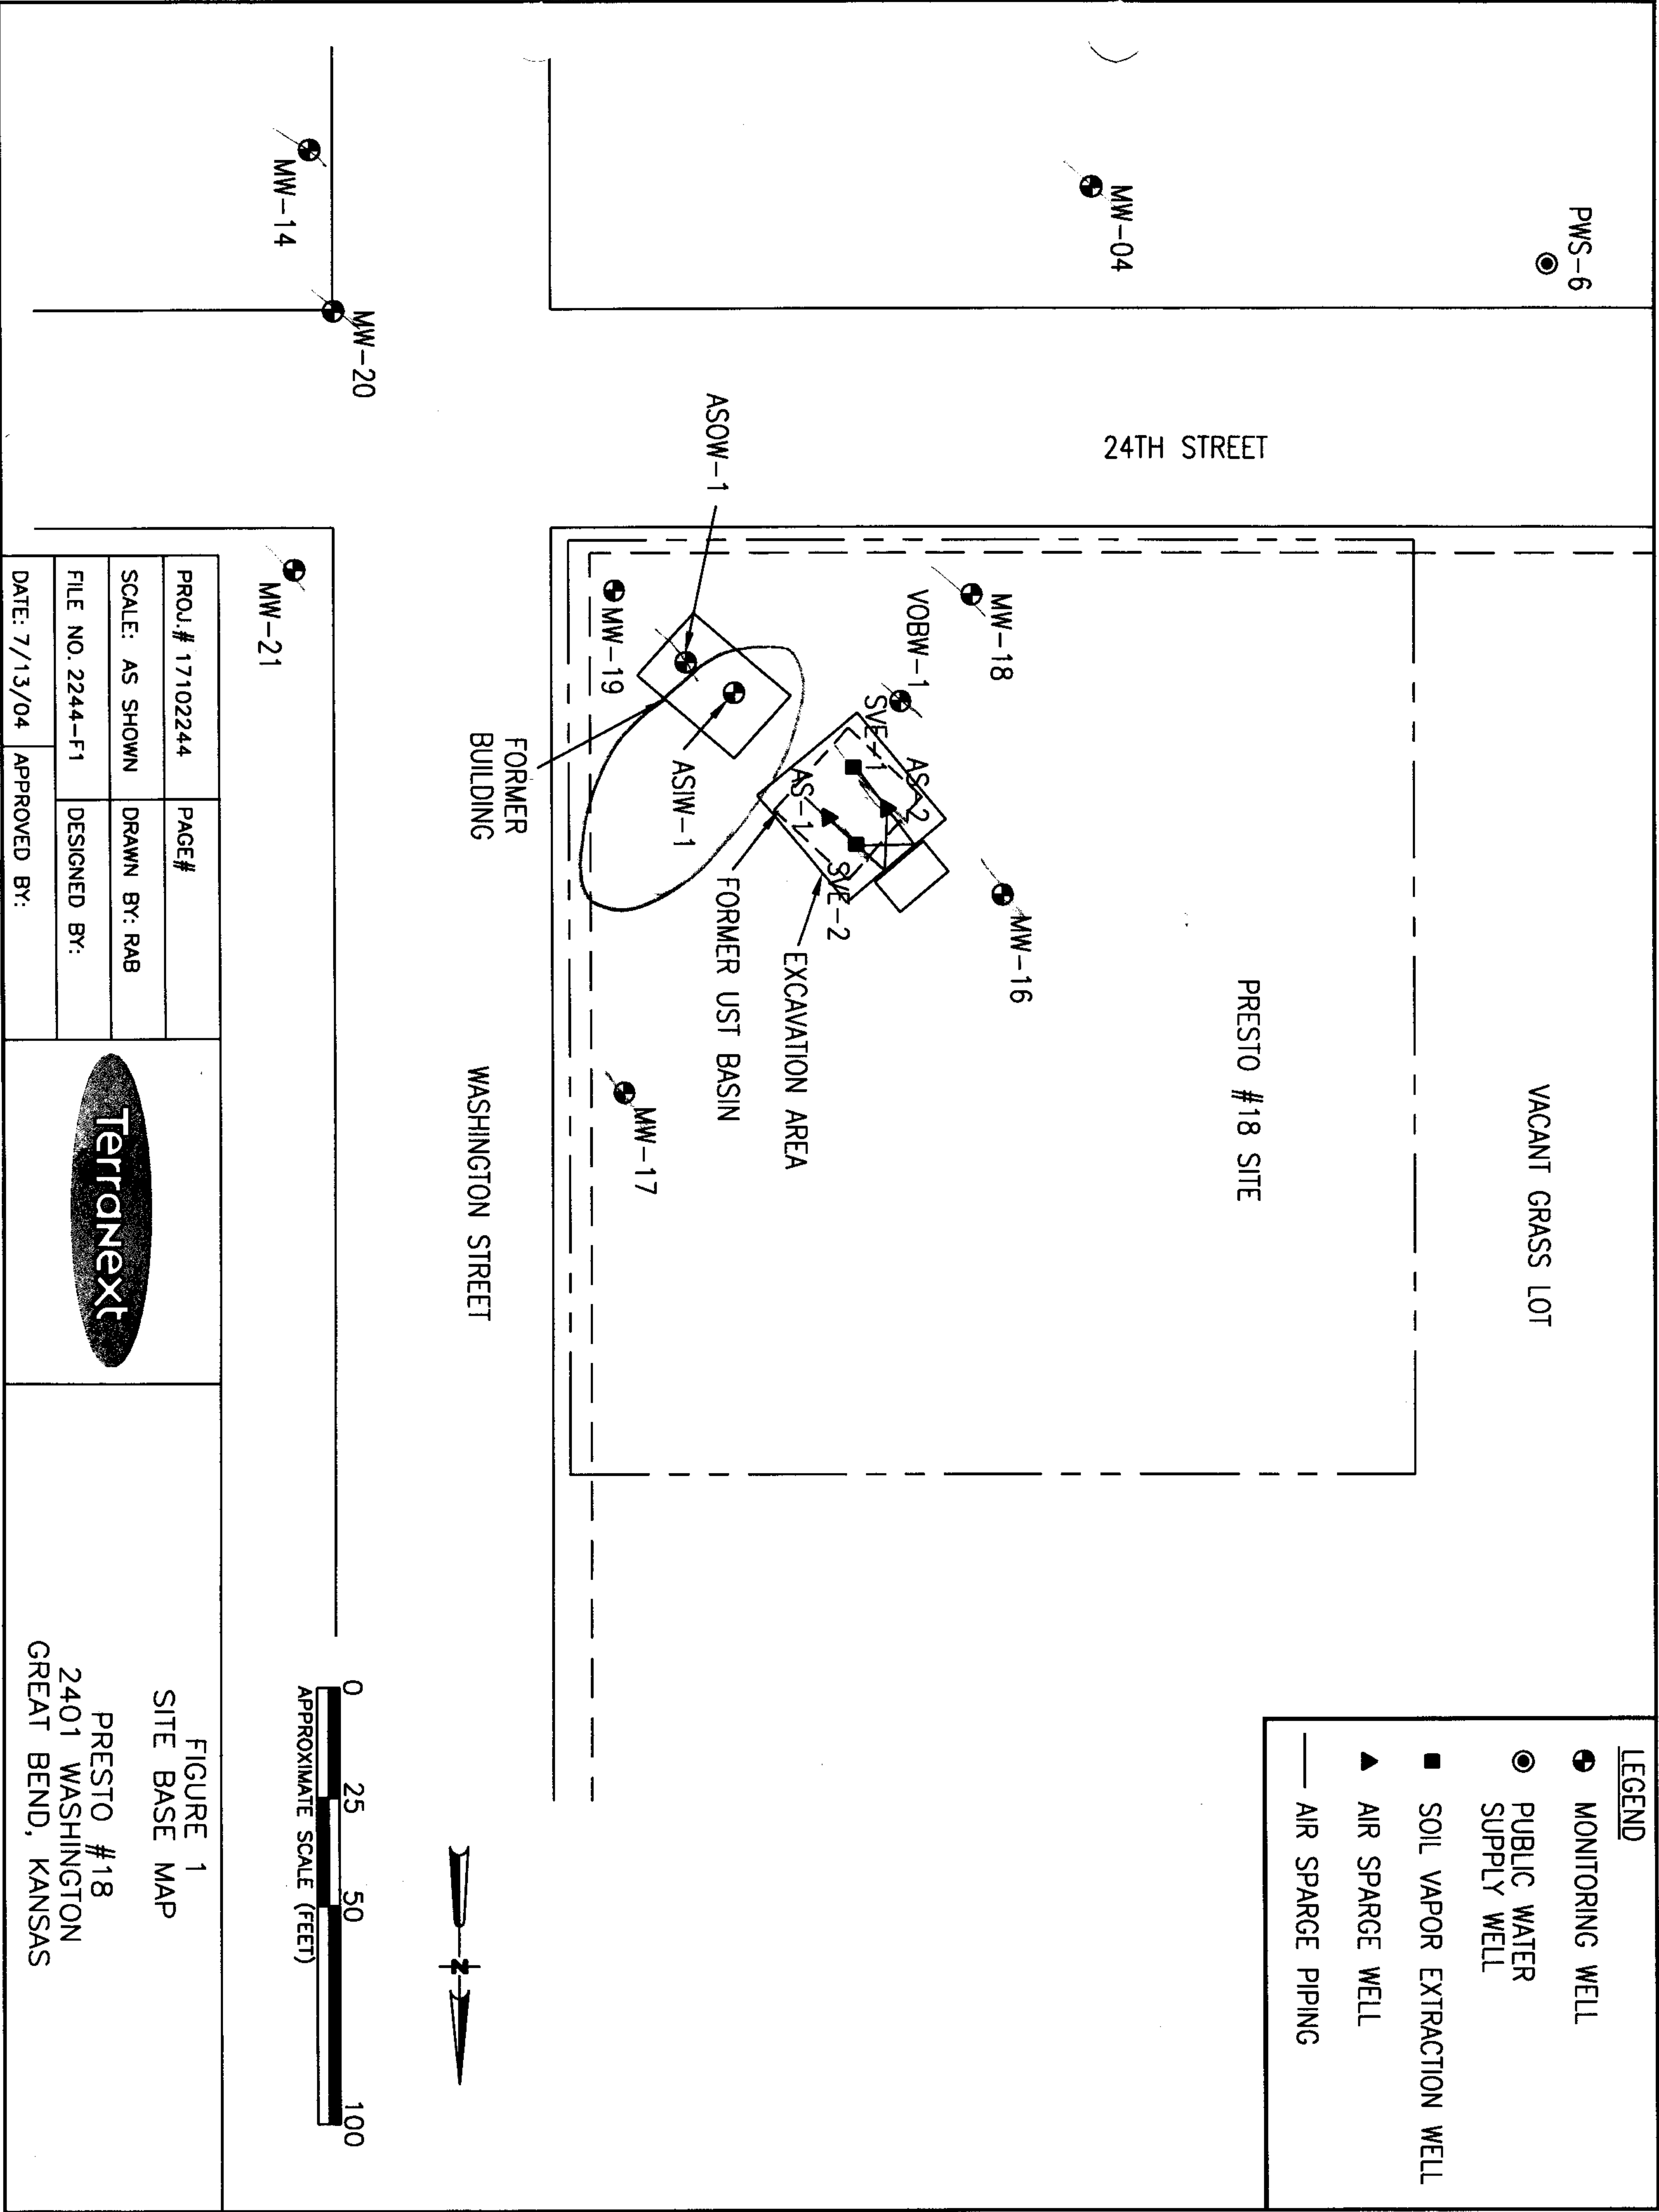

2244

BIEKER SURVEYING
1718 HENRY DRIVE
HAYS, KANSAS 67601
PHONE 785-628-8670
June 29, 2002
Page 1 of 2

BE&K TERRANEXT
13202 West 98th Street
Lenexa, Kansas 66215

Re: Surveying for Monitor Wells
Presto #18
2401 Washington Street
Great Bend, Barton County, Kansas

The above site is in Section 20, Township 19 South, Range 13 West of the Sixth Principal Meridian, Barton County, Kansas. The Southeast corner of Section 20 assigned coordinates of North 00.00 and West 00.00. The line connecting the Southeast and Northeast corners of Section 20 was assigned a bearing of North-South.

The Vertical control is from a USGS Brass cap stamped "V 29 1934" 58 feet East of center of Highway 281 and 57 feet South of center of ATSF railroad tracts. Elevation = 1849.33 feet.

The Control Point is a bolt in concrete around monitor well 19 and is 27 feet North of curb on North side of 24th Street and 31 feet West of Curb on West side of Washington Street.

The latitude and longitude were determined from GPS equipment.

The coordinates, latitude, longitude and elevations are listed on the following page of this report.



RECEIVED

DEC - 2 2019

BUREAU OF WATER


RECEIVED

FEB 14 2020

KS GEOLOGICAL SURVEY

June 29, 2002
Page 2 of 2

Re: Surveying for Monitor Wells
Presto #18
2401 Washington Street
Great Bend, Barton County, Kansas

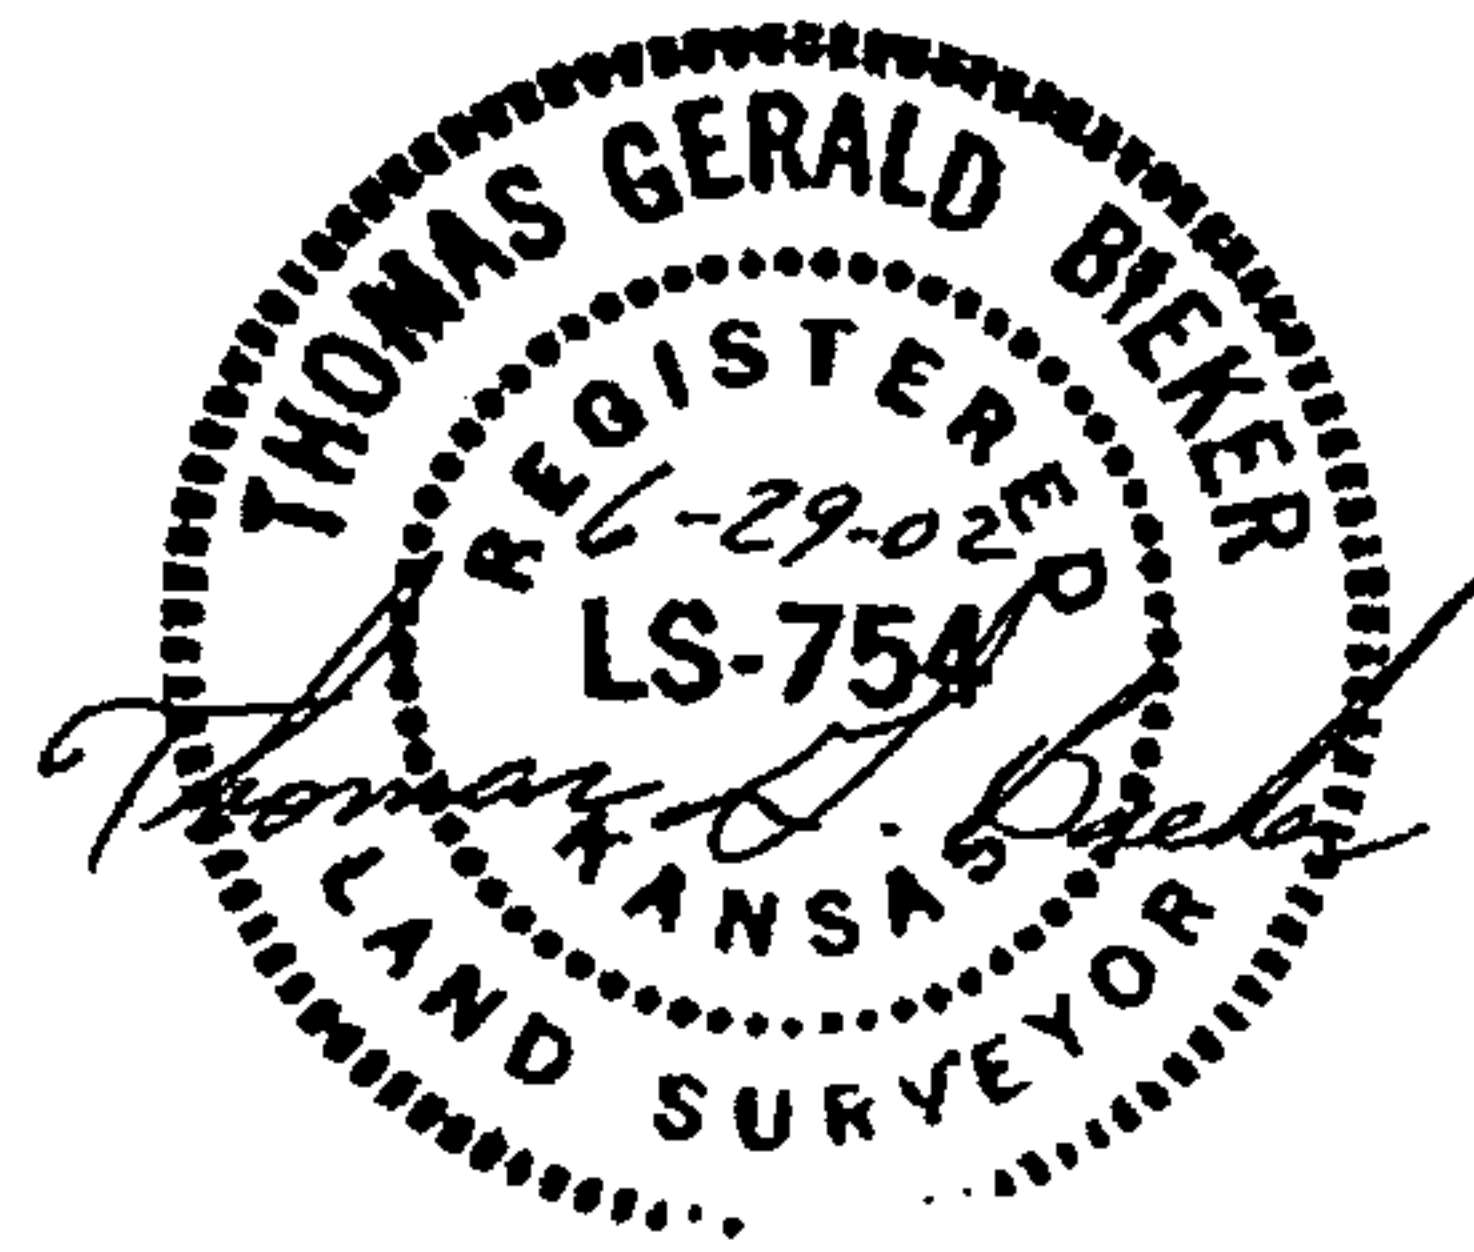

Wells were surveyed using existing control point on site.

	NORTH	WEST	LATITUDE D-M-S	LONGITUDE D-M-S	ELEVATION
SE Corner 20-19-13	00.00	00.00	38-22-35	98-46-28	
Control Point SE-SE-SE-SE	69.33	71.85	38-22-35	98-46-29	1852.16 BOLT <i>(38,76666 - 98,774722 NAD83)</i>
MW SVE-2 SE-SE-SE-SE	124.61	126.32	38-22-36	98-46-29	1852.00 HOLE 1851.60 TOC
MW AS-1 SE-SE-SE-SE	112.76	113.92	38-22-36	98-46-29	1852.24 HOLE 1851.69 TOC
MW SVE-1 SE-SE-SE-SE	105.50	122.55	38-22-36	98-46-29	1852.22 HOLE 1851.86 TOC
MW AS-2 SE-SE-SE-SE	113.63	133.73	38-22-36	98-46-29	1852.11 HOLE 1851.52 TOC
MW 21 SEC 21, T13S, R19W SW-SW-SW -SW	67.59	-25.34	38-22-35	98-46-27	1851.45 HOLE 1850.92 TOC

Note: MW 21 falls in Section 21-19-13 with Northing and Westing relative to this site.
Westing is therefore a negative number. All other wells are in Sec. 20, T19S,
R13W.

HOLE elevation is a 3/16 hole drilled in North side of monitor well rim.