

County: Barton Fraction: NW NW NW Sec. 28 T. 19 S R. 13 W

CORRECTION(S) to WATER WELL COMPLETION RECORD Form WWC-5 (to rectify lacking or incorrect information)

Owner: Presto 18 MW 14

If location corrected, was listed as:

Section-Township-Range: 28-19-13W

Fraction (1/4 calls): NW NW NW

Location changed to:

Other changes: Initial statements: Central Kansas Surveying & Mapping

Changed to: Presto 18 Elevation 1852.45

Comments:


Verification method: Per site map & memorandum from KDHE 12-01-2019

Initials: SH Date: 04-22-2020

Submitted by: ☒ Kansas Geological Survey, Data Resources Library, 1930 Constant Ave., Lawrence, KS 66047-3724
☐ Kansas Dept. of Health & Environment, Bureau of Water, 1000 SW Jackson, Suite 420, Topeka, KS 66612-1367

1	LOCATION OF WATER WELL: County: Barton	Fraction NW 1/4 NW 1/4 NW 1/4	Section 28	Number	Township 19 S	Number	Range 13	Number E 1/4																								
Distance and direction from nearest town or city street address of well if located within city? 2344 Washington, Great Bend																																
2	WATER WELL OWNER: Central Kansas Surveying & Mapping, Inc. RR #, St. Address, Box #: 2344 Washington City, State, ZIP Code: Great Bend, KS 67530 Board of Agriculture, Division of Water Resources Application Number:																															
3	MARK WELL'S LOCATION WITH AN "X" IN SECTION BOX: <table border="1" style="margin: auto; border-collapse: collapse;"><tr><td colspan="2" style="text-align: center;">N</td></tr><tr><td style="text-align: center;">X</td><td style="text-align: center;"></td></tr><tr><td style="text-align: center;">NW</td><td style="text-align: center;">NE</td></tr><tr><td style="text-align: center;">W</td><td style="text-align: center;">E</td></tr><tr><td style="text-align: center;">SW</td><td style="text-align: center;">SE</td></tr><tr><td colspan="2" style="text-align: center;">S</td></tr></table>		N		X		NW	NE	W	E	SW	SE	S		4																	
N																																
X																																
NW	NE																															
W	E																															
SW	SE																															
S																																
		DEPTH OF WELL 19.2 ft. WELL'S STATIC WATER LEVEL 15.9 ft. WELL WAS USED AS: <table style="width:100%;"><tr><td>1 Domestic</td><td>5 Public Water Supply</td><td>9 Dewatering</td></tr><tr><td>2 Irrigation</td><td>6 Oil Field Water Supply</td><td>☒ 10 Monitoring Well</td></tr><tr><td>3 Feedlot</td><td>7 Domestic (Lawn & Garden)</td><td>11 Injection Well</td></tr><tr><td>4 Industrial</td><td>8 Air Conditioning</td><td>12 Other</td></tr></table> Was a chemical / bacteriological sample submitted to Department? Yes No X If yes, mo/day/yr sample was submitted Water Well Disinfected: Yes No X							1 Domestic	5 Public Water Supply	9 Dewatering	2 Irrigation	6 Oil Field Water Supply	☒ 10 Monitoring Well	3 Feedlot	7 Domestic (Lawn & Garden)	11 Injection Well	4 Industrial	8 Air Conditioning	12 Other												
1 Domestic	5 Public Water Supply	9 Dewatering																														
2 Irrigation	6 Oil Field Water Supply	☒ 10 Monitoring Well																														
3 Feedlot	7 Domestic (Lawn & Garden)	11 Injection Well																														
4 Industrial	8 Air Conditioning	12 Other																														
5	TYPE OF BLANK CASING USED: <table style="width:100%;"><tr><td>1 Steel</td><td>3 RMP (SR)</td><td>5 Wrought</td><td>7 Fiberglass</td><td>9 Other (Specify below)</td></tr><tr><td>☒ 2 PVC</td><td>4 ABS</td><td>6 Asbestos-Cement</td><td>8 Concrete Tile</td><td>.....</td></tr></table> Blank casing diameter 2 in. Was casing pulled? Yes X No If yes, how much 19.2 in. Casing height above <u>below</u> land surface 0 in.								1 Steel	3 RMP (SR)	5 Wrought	7 Fiberglass	9 Other (Specify below)	☒ 2 PVC	4 ABS	6 Asbestos-Cement	8 Concrete Tile															
1 Steel	3 RMP (SR)	5 Wrought	7 Fiberglass	9 Other (Specify below)																												
☒ 2 PVC	4 ABS	6 Asbestos-Cement	8 Concrete Tile																													
6	GROUT PLUG MATERIAL: 1 Neat cement 2 Cement grout ☒ 3 Bentonite 4 Other Grout Plug Intervals: From 20 ft. to 1 ft., From ft. to ft., From to ft. What is the nearest source of possible contamination: <table style="width:100%;"><tr><td>1 Septic tank</td><td>6 Seepage pit</td><td>11 Fuel storage</td><td>16 Other (specify below)</td></tr><tr><td>2 Sewer lines</td><td>7 Pit privy</td><td>12 Fertilizer storage</td><td>.....</td></tr><tr><td>☒ 3 Watertight sewer lines</td><td>8 Sewage lagoon</td><td>13 Insecticide storage</td><td></td></tr><tr><td>4 Lateral lines</td><td>9 Feedyard</td><td>14 Abandoned water well</td><td></td></tr><tr><td>5 Cess pool</td><td>10 Livestock pens</td><td>15 Oil well/Gas well</td><td></td></tr></table> Direction from well? North How many feet? 30								1 Septic tank	6 Seepage pit	11 Fuel storage	16 Other (specify below)	2 Sewer lines	7 Pit privy	12 Fertilizer storage		☒ 3 Watertight sewer lines	8 Sewage lagoon	13 Insecticide storage		4 Lateral lines	9 Feedyard	14 Abandoned water well		5 Cess pool	10 Livestock pens	15 Oil well/Gas well					
1 Septic tank	6 Seepage pit	11 Fuel storage	16 Other (specify below)																													
2 Sewer lines	7 Pit privy	12 Fertilizer storage																														
☒ 3 Watertight sewer lines	8 Sewage lagoon	13 Insecticide storage																														
4 Lateral lines	9 Feedyard	14 Abandoned water well																														
5 Cess pool	10 Livestock pens	15 Oil well/Gas well																														
<table border="1" style="width:100%; border-collapse: collapse;"><thead><tr><th style="width:10%;">FROM</th><th style="width:10%;">TO</th><th style="width:80%;">PLUGGING MATERIALS</th></tr></thead><tbody><tr><td style="text-align: center;">20</td><td style="text-align: center;">1</td><td>3/8 Bentonite Chips</td></tr><tr><td style="text-align: center;">1</td><td style="text-align: center;">0</td><td>Soil and Gravel</td></tr><tr><td> </td><td> </td><td> </td></tr><tr><td> </td><td> </td><td> </td></tr><tr><td> </td><td> </td><td> </td></tr><tr><td> </td><td> </td><td> </td></tr><tr><td> </td><td> </td><td> </td></tr></tbody></table>									FROM	TO	PLUGGING MATERIALS	20	1	3/8 Bentonite Chips	1	0	Soil and Gravel															
FROM	TO	PLUGGING MATERIALS																														
20	1	3/8 Bentonite Chips																														
1	0	Soil and Gravel																														
7	CONTRACTOR'S OF LANDOWNER'S CERTIFICATION: This water well was plugged under my jurisdiction and was completed on (mo/day/year) 10-25-05 and this record is true to the best of my knowledge and belief. Kansas Water Well Contractor's License No. 665 This Water Well Record was completed on (mo/day/year) 10-26-05 under the business name of Pratt Well Environmental by (signature) <i>[Signature]</i>																															
INSTRUCTIONS: Use typewriter or ball point pen. Please press firmly and print clearly. Please fill in blanks, underline or circle the correct answers. Send top three copies to Kansas Department of Health and Environment, Bureau of Water, Geology Section, 1000 SW Jackson St., Ste. 420, Topeka, Kansas 66612-1367. Telephone: 785/296-5522. Send one to Water Well Owner and retain one for your records.																																

MW14

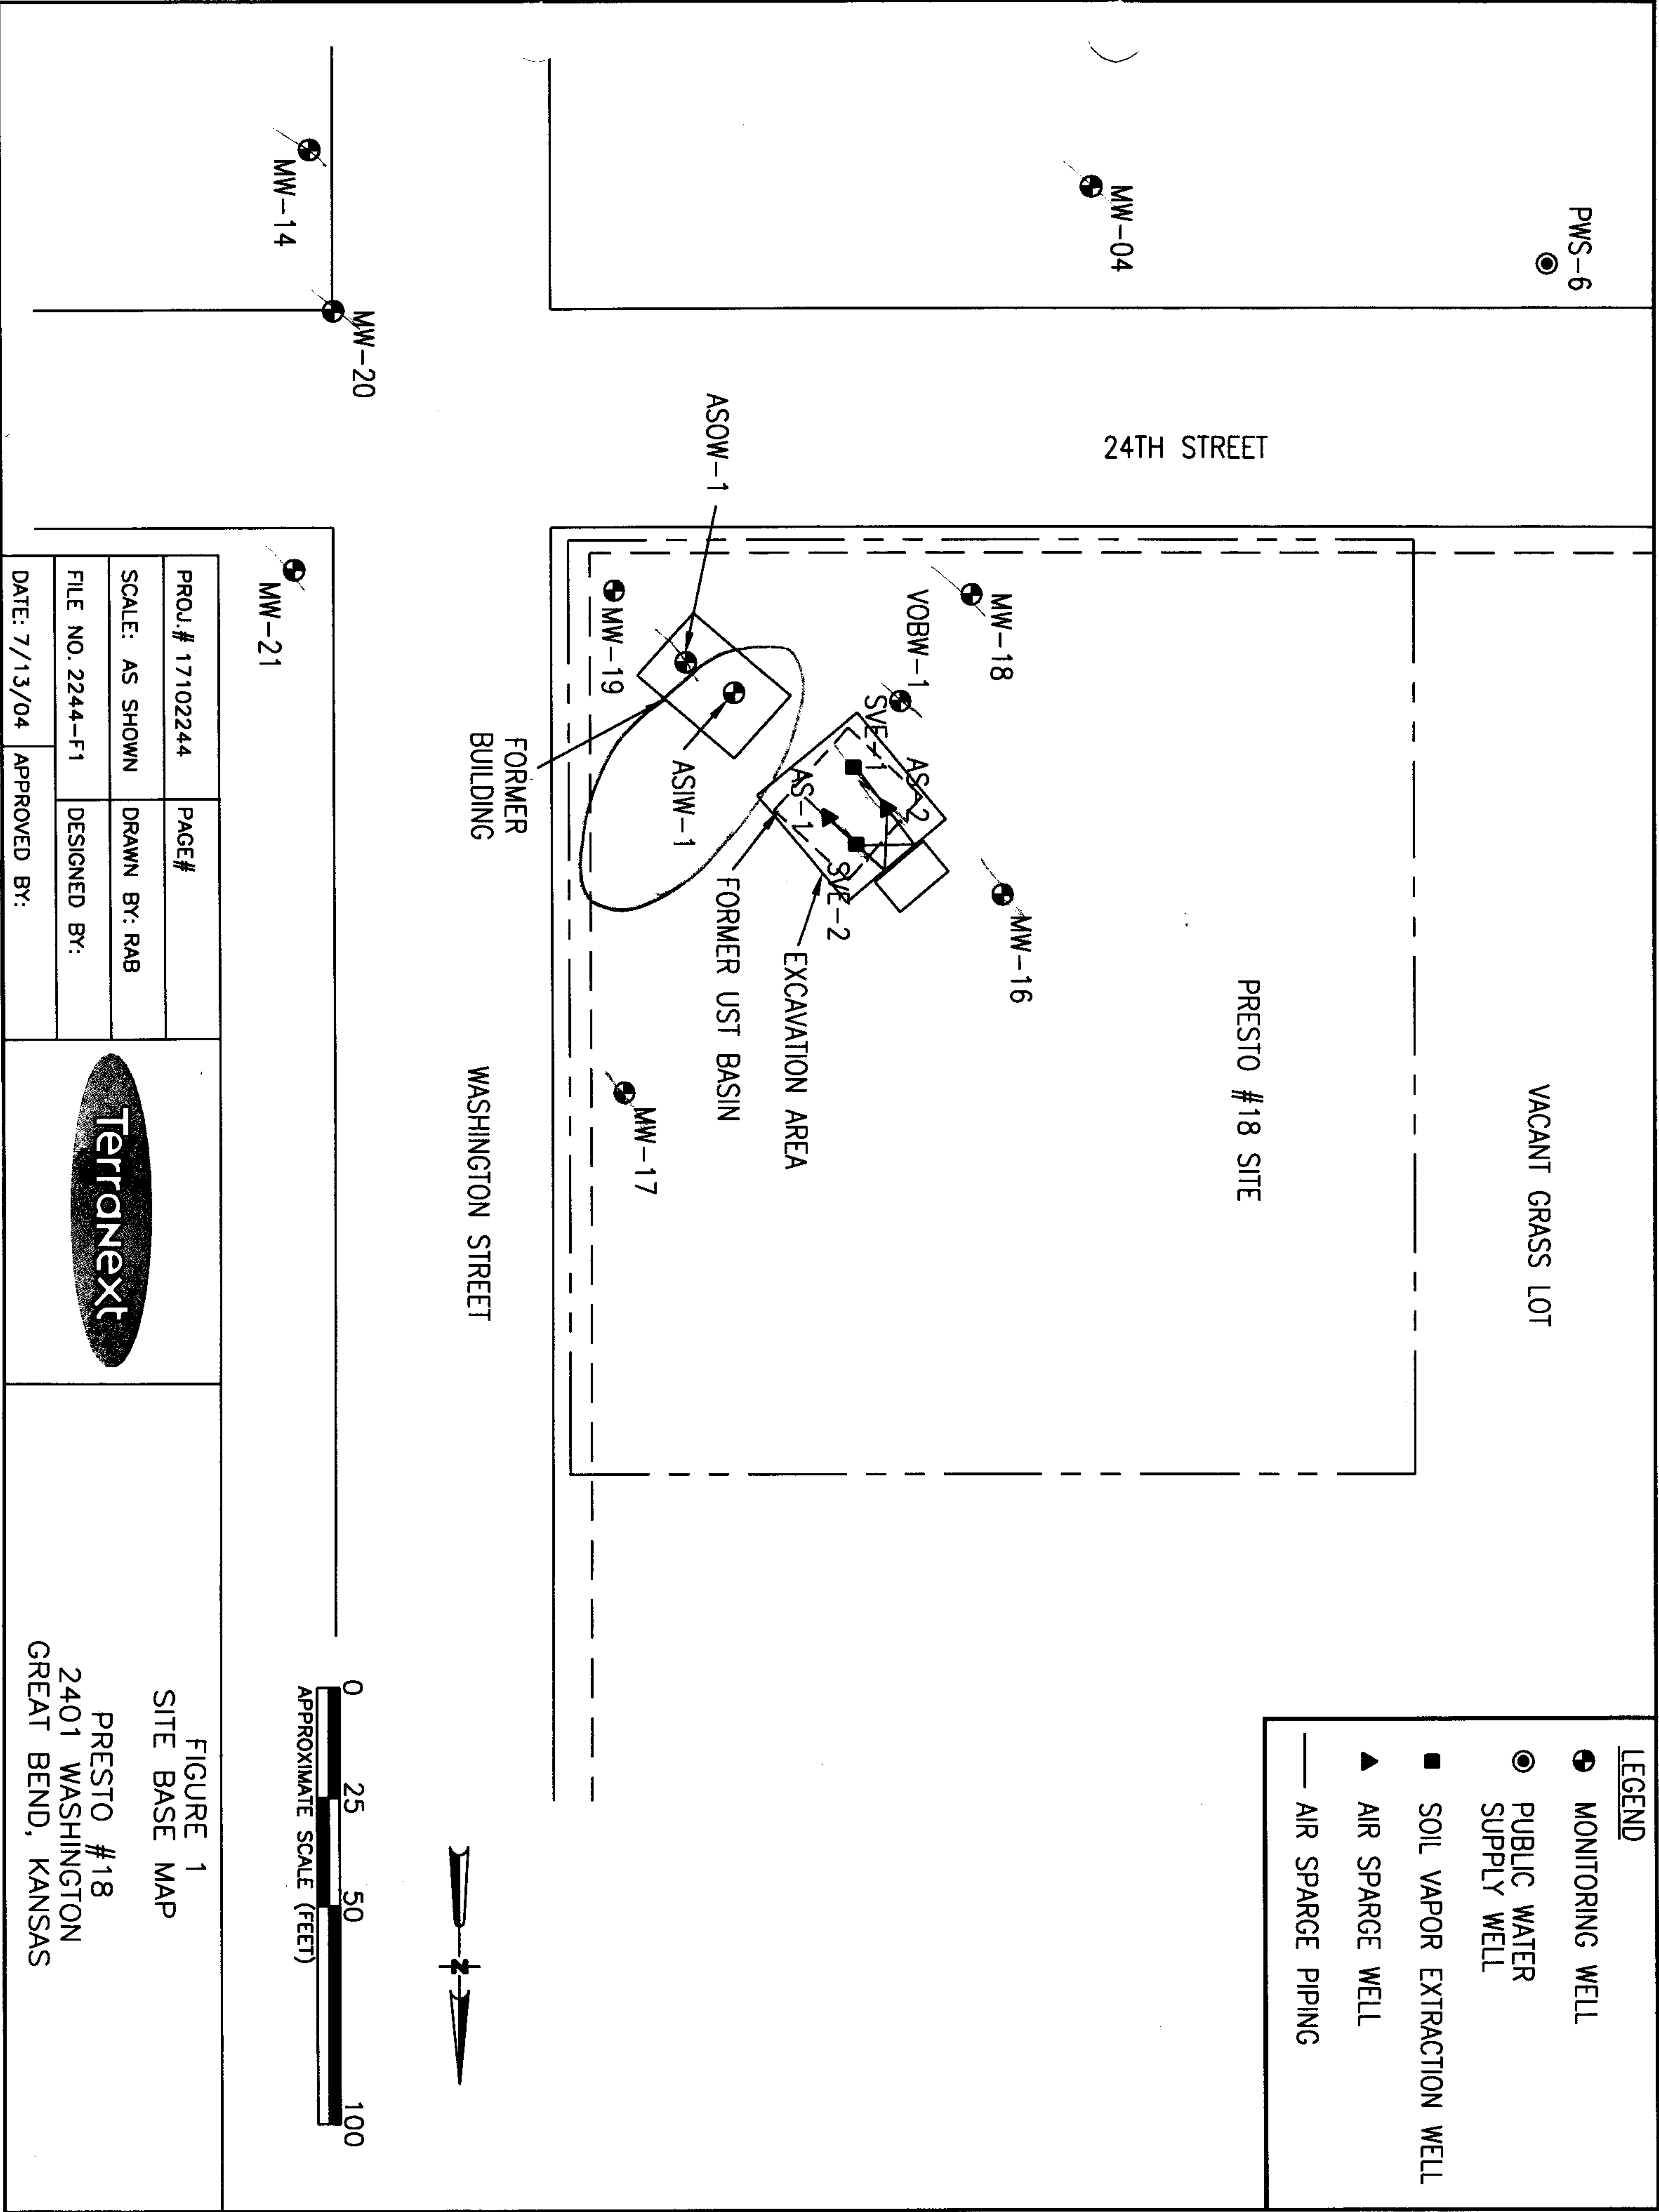

LEGEND

- MONITORING WELL
- ⊙ PUBLIC WATER SUPPLY WELL
- SOIL VAPOR EXTRACTION WELL
- ▲ AIR SPARGE WELL
- AIR SPARGE PIPING

PROJ. # 17102244	PAGE #
SCALE: AS SHOWN	DRAWN BY: RAB
FILE NO. 2244-F1	DESIGNED BY:
DATE: 7/13/04	APPROVED BY:



FIGURE 1
SITE BASE MAP

PRESTO #18
2401 WASHINGTON
GREAT BEND, KANSAS