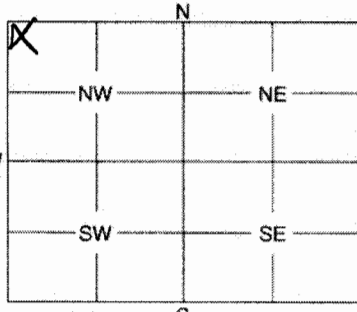


1	LOCATION OF WATER WELL: Barton	Fraction NW $\frac{1}{4}$ NW $\frac{1}{4}$ NW $\frac{1}{4}$	Section 33	Township 19S	Range 13	Number EW																								
County: Barton Distance and direction from nearest town or city street address of well if located within city? Former Ames Oil Company 2542 W. 10th Street																														
2	WATER WELL OWNER: Former Ames Oil RR #, St. Address, Box #: 2542 W. 10th Street City, State, ZIP Code : Great Bend, Ks 67530																													
Board of Agriculture, Division of Water Resources Application Number:																														
3	MARK WELL'S LOCATION WITH AN "X" IN SECTION BOX: 		4	DEPTH OF WELL 22.05 ft. WELL'S STATIC WATER LEVEL 9.28 ft. WELL WAS USED AS: 1 Domestic 2 Irrigation 3 Feedlot 4 Industrial 5 Public Water Supply 6 Oil Field Water Supply 7 Domestic (Lawn & Garden) 8 Air Conditioning 9 Dewatering 10 Monitoring Well 11 Injection Well 12 Other																										
Was a chemical / bacteriological sample submitted to Department? Yes No X If yes, mo/day/yr sample was submitted Water Well Disinfected: Yes No X																														
5	TYPE OF BLANK CASING USED: 1 Steel 2 PVC 3 RMP (SR) 4 ABS 5 Wrought 6 Asbestos-Cement 7 Fiberglass 8 Concrete Tile 9 Other (Specify below) Blank casing diameter 2 in. Was casing pulled? Yes X No If yes, how much 20' Casing height above or below land surface in.																													
6	GROUT PLUG MATERIAL: 3 Neat cement 2 Cement grout 3 Bentonite 4 Other Concrete Grout Plug Intervals: From 20 ft. to 5 ft. From 5 ft. to 0 ft. From to ft. What is the nearest source of possible contamination: 1 Septic tank 2 Sewer lines 3 Watertight sewer lines 4 Lateral lines 5 Cess pool 6 Seepage pit 7 Pit privy 8 Sewage lagoon 9 Feedyard 10 Livestock pens 11 Fuel storage 12 Fertilizer storage 13 Insecticide storage 14 Abandoned water well 15 Oil well/Gas well 16 Other (specify below) Direction from well? How many feet?																													
<table border="1" style="width:100%; border-collapse: collapse;"> <thead> <tr> <th style="width:10%;">FROM</th> <th style="width:10%;">TO</th> <th style="width:80%;">PLUGGING MATERIALS</th> </tr> </thead> <tbody> <tr> <td>20</td> <td>.5</td> <td>Bentonite</td> </tr> <tr> <td>.5</td> <td>0</td> <td>Concrete</td> </tr> <tr> <td></td> <td></td> <td>Overdrilled to 20'</td> </tr> <tr><td> </td><td> </td><td> </td></tr> <tr><td> </td><td> </td><td> </td></tr> <tr><td> </td><td> </td><td> </td></tr> <tr><td> </td><td> </td><td> </td></tr> </tbody> </table>							FROM	TO	PLUGGING MATERIALS	20	.5	Bentonite	.5	0	Concrete			Overdrilled to 20'												
FROM	TO	PLUGGING MATERIALS																												
20	.5	Bentonite																												
.5	0	Concrete																												
		Overdrilled to 20'																												
7	CONTRACTOR'S OF LANDOWNER'S CERTIFICATION: This water well was plugged under my jurisdiction and was completed on (mo/day/year) 09/13/06 and this record is true to the best of my knowledge and belief. Kansas Water Well Contractor's License No. 09/11/06 This Water Well Record was completed on (mo/day/year) 09/27/06 under the business name of Associated Environmental, Inc. by (signature) B. Johnson																													

INSTRUCTIONS: Use typewriter or ball point pen. Please press firmly and print clearly. Please fill in blanks, underline or circle the correct answers. Send top three copies to Kansas Department of Health and Environment, Bureau of Water, Geology Section, 1000 SW Jackson St., Ste. 420, Topeka, Kansas 66612-1367. Telephone: 785/296-5522. Send one to Water Well Owner and retain one for your records.