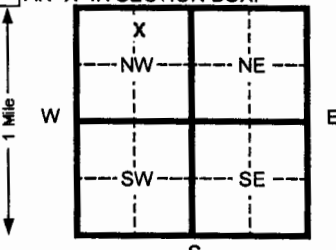


1 LOCATION OF WATER WELL:		Fraction	Section Number		Township Number		Range Number	
County: Barton		NW ¼ NE ¼ NW ¼	16		T 19 S		R 13 W	
Distance and direction from nearest town or city street address of well if located within city?								
31 East 30 Road – Great Bend KS								
2 WATER WELL OWNER: Ms. Janice Roughton – R&J Mini-Mart								
RR#, St. Address, Box # : 4314 Trinity Dr.			Board of Agriculture, Division of Water Resources					
City, State, ZIP Code : Shawnee, OK 74801			Application Number:					
3 LOCATE WELL'S LOCATION WITH AN "X" IN SECTION BOX:			4 DEPTH OF COMPLETED WELL 25 ft. ELEVATION: 1847.8528 (TOC)					
			Depth(s) Groundwater Encountered 1 9 ft. 2 ft. 3 ft.					
			WELL'S STATIC WATER LEVEL ft. below land surface measured on mo/day/yr					
			Pump test data: Well water was ft. after hours pumping gpm					
			Est. Yield gpm Well water was ft. after hours pumping gpm					
			Bore Hole Diameter 8.25 in. to 26.5 ft. and in. to ft.					
			WELL WATER TO BE USED AS: 5 Public water supply 8 Air conditioning 11 Injection well					
			1 Domestic 3 Feed lot 6 Oil field water supply 9 Dewatering 12 Other (Specify below)					
			2 Irrigation 4 Industrial 7 Lawn and garden (domestic) 10 Monitoring well					
			Was a chemical/bacteriological sample submitted to Department? Yes No X If yes, mo/day/yr sample was submitted					
			Water Well Disinfected? Yes No X					
5 TYPE OF BLANK CASING USED:								
1 Steel 3 RMP (SR)			5 Wrought Iron 8 Concrete tile			CASING JOINTS: Glued Clamped		
2 PVC 4 ABS			6 Asbestos-Cement 9 Other (specify below)			Welded		
			7 Fiberglass			Threaded Flush		
Blank casing diameter 2 in. to 10 ft., Dia in. to ft., Dia in. to ft.								
Casing height above land surface Flushmount in., weight 0.703 lbs./ft. Wall thickness or gauge No. SCH. 40								
TYPE OF SCREEN OR PERFORATION MATERIAL:								
1 Steel 3 Stainless steel 5 Fiberglass 8 RMP (SR) 11 Other (specify)			7 PVC 10 Asbestos-cement					
2 Brass 4 Galvanized steel 6 Concrete tile 9 ABS 12 None used (open hole)								
SCREEN OR PERFORATION OPENINGS ARE:								
1 Continuous slot 3 Mill slot 6 Wire wrapped 9 Drilled holes 10 Other (specify)			5 Gauzed wrapped 8 Saw cut 11 None (open hole)					
2 Louvered shutter 4 Key punched 7 Torch cut								
SCREEN-PERFORATED INTERVALS: From 10 ft. to 25 ft. From ft. to ft.								
GRAVEL PACK INTERVALS: From 8 ft. to 26.5 ft. From ft. to ft.								
6 GROUT MATERIAL: 1 Neat cement 2 Cement grout 3 Bentonite 4 Other								
Grout Intervals From 8 ft. to 1 ft. From ft. to ft. From ft. to ft.								
What is the nearest source of possible contamination:								
1 Septic tank 4 Lateral lines 7 Pit privy 10 Livestock pens 14 Abandoned water well			11 Fuel storage 15 Oil well/ Gas well					
2 Sewer lines 5 Cess pool 8 Sewage lagoon 12 Fertilizer storage 16 Other (specify below)								
3 Watertight sewer lines 6 Seepage pit 9 Feedyard 13 Insecticide storage								
Direction from well? How many feet?								
FROM TO CODE LITHOLOGIC LOG FROM TO PLUGGING INTERVALS								
0 0.5 Topsoil								
0.5 9.0 Clay, silty, dark brown, medium stiff								
9.0 20.0 Clay, silty, light gray, very soft								
20.0 21.3 Sand, coarse grained								
21.3 25.3 Clay, with sand, stiff								
25.3 25.8 Sand, fine grained								
25.8 26.0 Clay, silty, dark gray, soft								
26.0 26.5 Sand, gravel sized								
7 CONTRACTOR'S OR LANDOWNER'S CERTIFICATION: This water well was (1) constructed, (2) reconstructed, or (3) plugged under my jurisdiction and was completed on (mo/day/yr) 07/26/07 and this record is true to the best of my knowledge and belief. Kansas Water Well Contractor's License No. 531 This Water Well Record was completed on (mo/day/yr) 08/17/07 under the business name of Geotechnical Services Inc. by (signature) [Signature]								
INSTRUCTIONS: Please fill in blanks and circle the correct answers. Send three copies to Kansas Department of Health and Environment, Bureau of Water, 1000 S W Jackson St. Ste. 420, Topeka, Kansas 66612-1367. Telephone: 913-296-5545. Send one to WATER WELL OWNER and retain one for your records.								