


1 LOCATION OF WATER WELL:	Fraction	Section Number	Township Number	Range Number
County: <u>Barton</u>	<u>SW 1/4 SE 1/4 NW 1/4</u>	<u>33</u>	<u>19</u>	<u>13</u> E.W.

Distance and direction from nearest town or city street address of well if located within city?

2302 Railroad Avenue, Great Bend, KS 67530

2 WATER WELL OWNER: <u>Moeder Oil Company</u> RR #, St. Address, Box #: <u>2302 Railroad Avenue</u> City, State, ZIP Code: <u>Great Bend KS 67530</u>	Board of Agriculture, Division of Water Resources Application Number:
---	--

3 MARK WELL'S LOCATION WITH AN "X" IN SECTION BOX:	4 DEPTH OF WELL <u>25</u> ft. WELL'S STATIC WATER LEVEL <u>9.5</u> ft. WELL WAS USED AS: <table style="width: 100%; border: none;"> <tr> <td style="width: 33%;">1 Domestic</td> <td style="width: 33%;">5 Public Water Supply</td> <td style="width: 33%;">9 Dewatering</td> </tr> <tr> <td>2 Irrigation</td> <td>6 Oil Field Water Supply</td> <td>10 Monitoring Well</td> </tr> <tr> <td>3 Feedlot</td> <td>7 Domestic (Lawn & Garden)</td> <td>☒ 11 Injection Well</td> </tr> <tr> <td>4 Industrial</td> <td>8 Air Conditioning</td> <td>12 Other</td> </tr> </table> Was a chemical / bacteriological sample submitted to Department? Yes No <u>X</u>..... If yes, mo/day/yr sample was submitted Water Well Disinfected: Yes No <u>X</u>.....	1 Domestic	5 Public Water Supply	9 Dewatering	2 Irrigation	6 Oil Field Water Supply	10 Monitoring Well	3 Feedlot	7 Domestic (Lawn & Garden)	☒ 11 Injection Well	4 Industrial	8 Air Conditioning	12 Other
1 Domestic	5 Public Water Supply	9 Dewatering											
2 Irrigation	6 Oil Field Water Supply	10 Monitoring Well											
3 Feedlot	7 Domestic (Lawn & Garden)	☒ 11 Injection Well											
4 Industrial	8 Air Conditioning	12 Other											

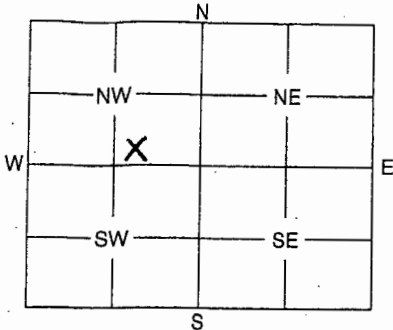

5 TYPE OF BLANK CASING USED:	9 Other (Specify below)
1 Steel 3 RMP (SR) 5 Wrought 7 Fiberglass ☒ 2 PVC 4 ABS 6 Asbestos-Cement 8 Concrete Tile	
Blank casing diameter <u>2</u> in.	Was casing pulled? Yes <u>X</u> No If yes, how much <u>3'</u>
Casing height above or <u>below</u> land surface <u>36</u> in.	

6 GROUT PLUG MATERIAL:	1 Neat cement 2 Cement grout ☒ 3 Bentonite 4 Other
Grout Plug Intervals: From <u>3</u> ft. to <u>25</u> ft., From ft. to ft., From to ft.	
What is the nearest source of possible contamination:	
1 Septic tank 6 Seepage pit ☒ 11 Fuel storage 2 Sewer lines 7 Pit privy 12 Fertilizer storage 3 Watertight sewer lines 8 Sewage lagoon 13 Insecticide storage 4 Lateral lines 9 Feedyard 14 Abandoned water well 5 Cess pool 10 Livestock pens 15 Oil well/Gas well	16 Other (specify below)
Direction from well? <u>N</u>	How many feet? <u>15</u>

FROM	TO	PLUGGING MATERIALS
25'	3'	<u>Bentonite chips</u>
3'	0'	<u>Native material</u>

7 CONTRACTOR'S OF LANDOWNER'S CERTIFICATION: This water well was plugged under my jurisdiction and was completed on (mo/day/year) <u>12-29-09</u>	and this record is true to the best of my knowledge and belief. Kansas Water Well Contractor's License No. This Water Well Record was completed on (mo/day/year) <u>2-5-10</u>
under the business name of <u>GreenField Contractors</u>	
by (signature) <u>[Signature]</u>	

INSTRUCTIONS: Use typewriter or ball point pen. Please press firmly and print clearly. Please fill in blanks, underline or circle the correct answers. Send top three copies to Kansas Department of Health and Environment, Bureau of Water, Geology Section, 1000 SW Jackson St., Ste. 420, Topeka, Kansas 66612-1367. Telephone: 785/296-5522. Send one to Water Well Owner and retain one for your records.