


1 LOCATION OF WATER WELL:						Fraction	Section Number			Township Number	Range Number
County:	Barton	NW	$\frac{1}{4}$	NW	$\frac{1}{4}$	NE	$\frac{1}{4}$	33	T 19 S	R 13 W	

Distance and direction from nearest town or city street address of well if located within city?
1925 10th St., Great Bend, KS

2	WATER WELL OWNER: KDHE	
RR#, St. Address, Box #	: 1000 SW Jackson Ste. 410	Board of Agriculture, Division of Water Resources
City, State, ZIP Code	: Topeka, KS 66612	Application Number:

3	LOCATE WELL'S LOCATION WITH AN "X" IN SECTION BOX:	4	DEPTH OF COMPLETED WELL	14	ft. ELEVATION:
---	--	---	-------------------------	----	----------------

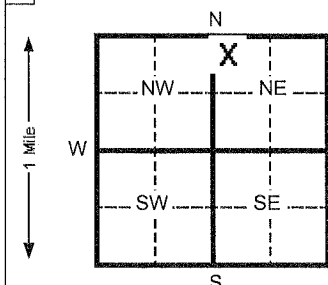

4 DEPTH OF COMPLETED WELL 14 ft. ELEVATION: _____

Depth(s) Groundwater Encountered 11.5 ft. 2 _____ ft. 3 _____ Ft.

WELL'S STATIC WATER LEVEL _____ ft. below land surface measured on mo/day/yr

Pump test data: Well water was _____ Ft. after _____ hours pumping _____ Gpm

Est. Yield _____ Gpm: Well water was _____ Ft. after _____ Hours pumping _____ Gpm

Bore Hole Diameter 8.25 in. to 14 ft. and _____ in. to _____ Ft.

WELL WATER TO BE USED AS:

5 Public water supply	8 Air conditioning	11 Injection well
1 Domestic	3 Feed lot	6 Oil field water supply
2 Irrigation	4 Industrial	7 Lawn and garden (domestic)
9 Dewatering	10 <u>Monitoring well</u>	12 Other (Specify below)

BMW-7R

Was a chemical/bacteriological sample submitted to Department? Yes _____ No X If yes, mo/day/yr sample was Submitted _____

Water Well Disinfected? Yes _____ No X

5 TYPE OF BLANK CASING USED:		5 Wrought Iron	8 Concrete tile	CASING JOINTS: Glued _____ Clamped _____	
1 Steel	3 RMP (SR)	6 Asbestos-Cement	9 Other (specify below)	Welded _____	
2 PVC	4 ABS	7 Fiberglass		Threaded	X

Blank casing diameter	<u>2</u>	in. to	<u>4</u>	ft., Dia	In. to	<u> </u>	ft., Dia	in. to	<u> </u>	ft.
Casing height above land surface	FLUSH		In., weight	SCH 40		Lbs./ft.	Wall thickness or gauge No.			

TYPE OF SCREEN OR PERFORATION MATERIAL:				7	PVC	10	Asbestos-cement
1	Steel	3	Stainless steel	5	Fiberglass	8	RMP (SR)
2	Brass	4	Galvanized steel	6	Concrete tile	9	ABS
						11	Other (specify) _____
						12	None used (open hole) _____

SCREEN OR PERFORATION OPENINGS ARE:			
1 Continuous slot	3 Mill slot	5 Gauzed wrapped	8 Saw cut
2 Louvered shutter	4 Key punched	6 Wire wrapped	9 Drilled holes
		7 Torch cut	10 Other (specify)
			11 None (open hole)

SCREEN-PERFORATED INTERVALS:	From	4	ft. to	14	ft. From		ft. to		ft.
	From		ft. to		ft. From		ft. to		Ft.
SAND PACK INTERVALS:	From	3.5	ft. to	14	ft. From		ft. to		Ft.
	From		ft. to		ft. From		ft. to		Ft.

6	GROUT MATERIAL:		1 Neat cement	2 Cement grout	3 Bentonite	4 Other									
Grout Intervals	From	2	0.5	ft. to	1	From	3	1	ft. to	3.5	ft. From		ft. to		ft.

What is the nearest source of possible contamination:			10 Livestock pens	14 Abandoned water well
1 Septic tank	4 Lateral lines	7 Pit privy	11 Fuel storage	15 Oil well/ Gas well
2 Sewer lines	5 Cess pool	8 Sewage lagoon	12 Fertilizer storage	16 Other (specify below)
3 Watertight sewer lines	6 Seepage pit	9 Feedyard	13 Insecticide storage	Contaminated Site

Direction from well? _____ How many feet? _____

[illegible]

7 CONTRACTOR'S OR LANDOWNER'S CERTIFICATION: This water well was (x) constructed, (2) reconstructed, or (3) plugged under my jurisdiction and was	
Completed on (mo/day/yr) 08/16/11	And this record is true to the best of my knowledge and belief. Kansas
Water Well Contractor's License No. 585	This Water Well Record was completed on (mo/day/yr) 08/26/11
under the business name of Associated Environmental, Inc.	Bv (signature) Bradley J. Johnson

INSTRUCTIONS: Please fill in blanks and circle the correct answers. Send three copies to Kansas Department of Health and Environment, Bureau of Water, Topeka, Kansas 66620-0001. Telephone: 913-296-5545. Send one to WATER WELL OWNER and retain one for your records.

OFFICE USE ONLY

1994


250