WATER WELL PLUGGING RECORD Form WWC-5P KSA 82a-1212 ID NO. 00168067

1 LOCATION OF WATER WELL:	Fraction	Section Number	Township Number	Range Number
County: BARTON	NE¼ SE ¼ NW ¼	20	19S	13 W

Distance and direction from nearest town or city street address of well if located within city?
Approx 1 mile N. of Great Bend, 100 yds W. of US Hwy 281

2 WATER WELL OWNER: Allied Cementing Co, Inc MW-1
RR #, St. Address, Box #: 3701 N. main
City, State, ZIP Code : GREAT BEND 67530
Board of Agriculture, Division of Water Resources Application Number:

3 MARK WELL'S LOCATION WITH AN "X" IN SECTION BOX:

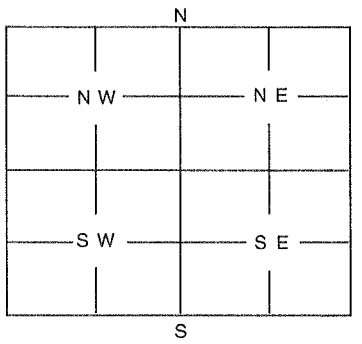

4 DEPTH OF WELL 19.7 ft
WELL'S STATIC WATER LEVEL 15 ft.
WELL WAS USED AS:

1 Domestic	5 Public Water Supply	9 Dewatering	
2 Irrigation	6 Oil Field Water Supply	(10) Monitoring Well	
3 Feedlot	7 Domestic (Lawn & Garden)	11 Injection Well	
4 Industrial	8 Air Conditioning	12 Other	

Was a chemical / bacteriological sample submitted to Department? Yes ✓ No
If yes, mo/day/yr sample was submitted 7-10-13 VOCs
Water Well Disinfected: Yes No NA

5 TYPE OF BLANK CASING USED:

1 Steel	3 RMP (SR)	5 Wrought	7 Fiberglass	9 Other (Specify below)
(2) PVC	4 ABS	6 Asbestos-Cement	8 Concrete Tile	

Blank casing diameter 2 in. Was casing pulled? Yes ✓ No If yes, how much Apx 19.7'
Casing height above or below land surface Dr.34 in.

6 GROUT PLUG MATERIAL: 1 Neat cement 2 Cement grout 3 Bentonite 4 Other Native Soil - MW-1 was removed via soil excavation.
Grout Plug Intervals: From ft. to ft., From ft. to ft., From to ft.

What is the nearest source of possible contamination:

1 Septic tank	(6) Seepage pit	(11) Fuel storage	16 Other (specify below)
(2) Sewer lines	7 Pit privy	12 Fertilizer storage	
3 Watertight sewer lines	8 Sewage lagoon	13 Insecticide storage	
4 Lateral lines	9 Feedyard	14 Abandoned water well	
5 Cess Pool	10 Livestock pens	15 Oil well/Gas well	

Direction from well? #6, 10 ft NW How many feet? ~10'

FROM	TO	PLUGGING MATERIALS
0	19.7	Native soil + Sand backfill in the excavation that included the area of MW-1

MW-1 pulled as part of planned excavation operations at the source area.

7 CONTRACTOR'S OR LANDOWNER'S CERTIFICATION: This water well was plugged under my jurisdiction and was completed on (mo/day/year) NA and this record is true to the best of my knowledge and belief. Kansas Water Well Contractor's License No. NA This Water Well Record was completed on (mo/day/year) 10-30-13 and under the business name of KDHE - Bill Heiman by (signature) Bill Heiman

INSTRUCTIONS: Use typewriter or ball point pen. Please press firmly and print clearly. Please fill in blanks, underline or circle the correct answers. Send top three copies to Kansas Department of Health and Environment, Bureau of Water, Topeka, Kansas 66620-0001. Telephone: 785/296-3565. Send one to Water Well Owner and retain one for your records.