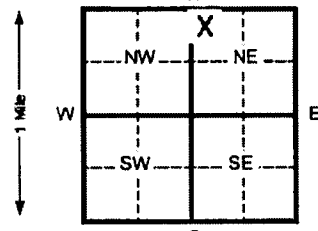


1 LOCATION OF WATER WELL:		Fraction		Section Number		Township Number		Range Number	
County: Barton		NW ¼ NW ¼ NE ¼		33		T 19 S		R 13 W	
Distance and direction from nearest town or city street address of well if located within city? 1000 Main St., Great Bend, KS									
2 WATER WELL OWNER: Coastal Mart									
RR#, St. Address, Box #: 9 Greenway Plaza									
City, State, ZIP Code: Houston, TX 77046									
Board of Agriculture, Division of Water Resources									
Application Number:									
3 LOCATE WELL'S LOCATION WITH AN "X" IN SECTION BOX:		4 DEPTH OF COMPLETED WELL 15 ft. ELEVATION:							
		Depth(s) Groundwater Encountered 1.5 9.5 ft. 2 ft. 3 ft. Ft.							
		WELL'S STATIC WATER LEVEL ft. below land surface measured on mo/day/yr							
		Pump test data: Well water was Ft. after hours pumping Gpm							
		Est. Yield Gpm: Well water was Ft. after hours pumping Gpm							
		Bore Hole Diameter 6.5 in. to 15 ft. and in. to ft.							
		WELL WATER TO BE USED AS: 5 Public water supply 8 Air conditioning 11 Injection well							
		1 Domestic 3 Feed lot 6 Oil field water supply 9 Dewatering 12 Other (Specify below)							
		2 Irrigation 4 Industrial 7 Lawn and garden (domestic) 10 Monitoring well CMW-2							
		Was a chemical/bacteriological sample submitted to Department? Yes No X If yes, mo/day/yr sample was Submitted							
		Water Well Disinfected? Yes No X							
5 TYPE OF BLANK CASING USED:									
1 Steel 3 RMP (SR) 5 Wrought Iron 8 Concrete tile CASING JOINTS: Glued Clamped									
2 PVC 4 ABS 6 Asbestos-Cement 9 Other (specify below) Welded									
7 Fiberglass Threaded X									
Blank casing diameter 2 in. to 4 ft., Dia in. to ft., Dia in. to ft.									
Casing height above land surface FLUSH in., weight SCH 40 Lbs./ft. Wall thickness or gauge No.									
TYPE OF SCREEN OR PERFORATION MATERIAL:									
1 Steel 3 Stainless steel 5 Fiberglass 7 PVC 10 Asbestos-cement									
2 Brass 4 Galvanized steel 6 Concrete tile 8 RMP (SR) 11 Other (specify)									
9 ABS 12 None used (open hole)									
SCREEN OR PERFORATION OPENINGS ARE:									
1 Continuous slot 3 Mill slot 5 Gauzed wrapped 8 Saw cut 11 None (open hole)									
2 Louvered shutter 4 Key punched 6 Wire wrapped 9 Drilled holes									
7 Torch cut 10 Other (specify)									
SCREEN-PERFORATED INTERVALS: From 4 ft. to 15 ft. From ft. to ft.									
From ft. to ft. From ft. to ft.									
SAND PACK INTERVALS: From 2.5 ft. to 15 ft. From ft. to ft.									
From ft. to ft. From ft. to ft.									
6 GROUT MATERIAL: 1 Neat cement 2 Cement grout 3 Bentonite 4 Other									
Grout Intervals From 2 0 ft. to 0.5 ft. From 3 0.5 ft. to 2.5 ft. From ft. to ft.									
What is the nearest source of possible contamination:									
1 Septic tank 4 Lateral lines 7 Pit privy 10 Livestock pens 14 Abandoned water well									
2 Sewer lines 5 Cess pool 8 Sewage lagoon 11 Fuel storage 15 Oil well/ Gas well									
3 Watertight sewer lines 6 Seepage pit 9 Feedyard 12 Fertilizer storage 16 Other (specify below)									
13 Insecticide storage Contaminated Site									
Direction from well? How many feet?									
FROM TO CODE LITHOLOGIC LOG FROM TO PLUGGING INTERVALS									
0 1 Cement									
1 2.5 Clay and Silt									
2.5 9 Sand									
9 15 Gravel and Sand									
15 TD End of Borehole									
7 CONTRACTOR'S OR LANDOWNER'S CERTIFICATION: This water well was (x) constructed, (2) reconstructed, or (3) plugged under my jurisdiction and w									
Completed on (mo/day/yr) 10/23/00 And this record is true to the best of my knowledge and belief. Kansas									
Water Well Contractor's License No. 585 This Water Well Record was completed on (mo/day/yr) 05/29/2014									
under the business name of Associated Environmental, Inc. By (signature) Bradley J. Johnson									
INSTRUCTIONS: Please fill in blanks and circle the correct answers. Send three copies to Kansas Department of Health and Environment, Bureau of Water, Topeka, Kansas 66620-0001. Telephone: 913-296-5545. Send one to WATER WELL OWNER and retain one for your records.									

OFFICE USE ONLY

1

2

SE