

WATER WELL PLUGGING RECORD Form WWC-5P KSA 82a-1212 ID NO.


1 **LOCATION OF WATER WELL:** Fraction 1/4 SE 1/4 NW 1/4 NW 1/4 Section Number 18 Township Number T 19 S Range Number 13 E W
 County: Barton

Street/Rural Address of Well Location; if unknown, distance & direction from nearest town or intersection: If at owner's address, check here 1 1/2 North of Great Bend

Global Positioning Systems (GPS) information:
 Latitude: _____ (in decimal degrees)
 Longitude: _____ (in decimal degrees)
 Elevation: _____
 Datum: WGS84, NAD83, NAD27
Collection Method:
 GPS unit (Make/Model: _____)
 Digital Map/Photo, Topographic Map, Land Survey
 Est. Accuracy: < 3 m, 3-5 m, 5-15 m, > 15 m

2 **WATER WELL OWNER:** Mid-America Feeders
 RR#, St. Address, Box #: PO Box 1387
 City, State ZIP Code: Great Bend, KS 67530

3 **MARK WELL'S LOCATION WITH AN "X" IN SECTION BOX:**

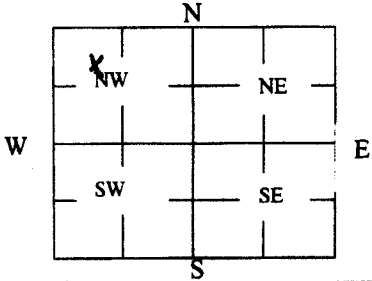

4 **DEPTH OF WELL** 68 ft.
WELL'S STATIC WATER LEVEL 24 ft.

WELL WAS USED AS:

- Domestic
- Public Water Supply
- Dewatering
- Irrigation
- Oil Field Water Supply
- Monitoring
- Feedlot
- Domestic (Lawn & Garden)
- Injection Well
- Industrial
- Air Conditioning
- Other _____

Was a chemical/bacteriological sample submitted to Department? Yes No

5 **TYPE OF BLANK CASING USED:**

- Steel
- RMP (SR)
- Wrought
- Fiberglass
- Other (Specify below) _____
- PVC
- ABS
- Asbestos-Cement
- Concrete Tile

Blank casing diameter 5 in. Was casing pulled? Yes No If yes, how much _____
 Casing height above or below land surface 36 in.

6 **GROUT PLUG MATERIAL:** Neat cement Cement grout Bentonite Other _____

Grout Plug Intervals: From 8 ft. to 3 ft., From _____ ft. to _____ ft., From _____ to _____ ft.

What is the nearest source of possible contamination:

- Septic tank
- Seepage pit
- Fuel Storage
- Sewer lines
- Pit privy
- Fertilizer storage
- Watertight sewer lines
- Sewage lagoon
- Insecticide storage
- Lateral lines
- Feedyard
- Abandoned water well
- Cess pool
- Livestock pens
- Oil well/Gas well
- Other (specify below) _____

Direction from well? West
 How many feet? 100ft

FROM	TO	PLUGGING MATERIALS	FROM	TO	PLUGGING MATERIALS
68	8	Hole plug			
8	3	Cement			

7 **CONTRACTOR'S OR LANDOWNER'S CERTIFICATION:** This water well was plugged under my jurisdiction and was completed on (mo/day/year) 4-13-15 and this record is true to the best of my knowledge and belief. Kansas Water Well Contractor's License No. 134. This Water Well Record was completed on (mo/day/year) 4-16-15 under the business name of Rosenkrantz-Bemis Ent Inc by (signature) [Signature]

INSTRUCTIONS: Use typewriter or ballpoint pen. Please press firmly and print clearly. Please fill in blanks, underline or circle the correct answers. Send one copy to Kansas Department of Health and Environment, Bureau of Water, Geology Section, 1000 SW Jackson St., Ste. 420, Topeka, Kansas 66612-1367. Telephone: 785/296-5524. Send one to Water Well Owner and retain one for your records. Visit us at <http://www.kdheks.gov/waterwell/index.html>.