WATER WELL PLUGGING RECORD Form WWC-5P KSA 82a-1212 ID NO.

1 LOCATION OF WATER WELL: County: Barton	Fraction: NW¼ SW¼ SW¼ NW¼	Section Number: 16	Township Number: T 19 S	Range Number: 13 ☐E ☒W

Street/Rural Address of Well Location; if unknown, distance & direction from nearest town or intersection: If at owner's address, check here ☐ 260 N. Washington Great Bend, KS 67530

Global Positioning Systems (GPS) information:
Latitude: _____ (in decimal degrees)
Longitude: _____ (in decimal degrees)
Elevation: _____
Horizontal Datum: ☐ WGS84, ☐ NAD83, ☐ NAD27
Collection Method:
☐ GPS unit (Make/Model: _____)
☐ Digital Map/Photo, ☐ Topographic Map, ☐ Land Survey
Est. Accuracy: ☐ <3 m, ☐ 3-5 m, ☐ 5-15 m, ☐ >15 m

2 WATER WELL OWNER: Carolyn Farris
RR#, St. Address, Box #: PO Box 1386
City, State ZIP Code: Great Bend, KS 67530

3 MARK WELL'S LOCATION WITH AN "X" IN SECTION BOX:

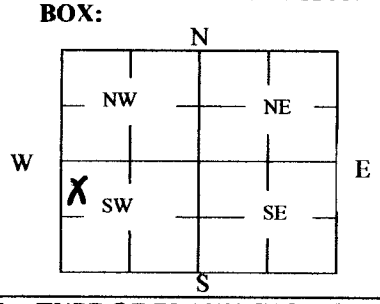

4 DEPTH OF WELL 115' 6" ft.
WELL'S STATIC WATER LEVEL 14' 6" ft
WELL WAS USED AS:

☒ Domestic	☐ Public Water Supply	☐ Dewatering	
☐ Irrigation	☐ Oil Field Water Supply	☐ Monitoring	
☐ Feedlot	☐ Domestic (Lawn & Garden)	☐ Injection Well	
☐ Industrial	☐ Air Conditioning	☐ Other _____	

Was a chemical/bacteriological sample submitted to Department? Yes ☐ No ☒

5 TYPE OF BLANK CASING USED:

☐ Steel	☐ RMP (SR)	☐ Wrought	☐ Fiberglass	☐ Other (Specify below)
☒ PVC	☐ ABS	☐ Asbestos-Cement	☐ Concrete Tile	

Blank casing diameter 4½ in. Was casing pulled? Yes ☐ No ☒ If yes, how much _____
Casing height above or below land surface _____ in.

6 GROUT PLUG MATERIAL: ☐ Neat cement ☐ Cement grout ☑ Bentonite ☐ Other _____

Grout Plug Intervals: From 115' 6" ft. to 4' 6" ft., From _____ ft. to _____ ft., From _____ ft. to _____ ft.

What is the nearest source of possible contamination:

☑ Septic tank	☐ Seepage pit	☐ Fuel storage	☐ Other (specify below)
☑ Sewer lines	☐ Pit privy	☐ Fertilizer storage	
☐ Watertight sewer lines	☐ Sewage lagoon	☐ Insecticide storage	
☐ Lateral lines	☐ Feedyard	☐ Abandoned water well	Direction from well? _____
☐ Cess pool	☐ Livestock pens	☐ Oil well/Gas well	How many feet? _____

FROM	TO	PLUGGING MATERIALS	FROM	TO	PLUGGING MATERIALS
115' 6"	4' 6"	3/8 chip Bentonite hole plug			
4' 6"	0'	Compacted Soil			

7 CONTRACTOR'S OR LANDOWNER'S CERTIFICATION: This water well was plugged under my jurisdiction and was completed on (mo/day/year) X 6/13/15 and this record is true to the best of my knowledge and belief. Kansas Water Well Contractor's License No. _____. This Water Well Record was completed on (mo/day/year) X 8/10/15 under the business name of _____ by (signature) X Carolyn Farris

Send one white copy to Kansas Department of Health & Environment, Geology Section, 1000 SW Jackson Street, Ste. 420, Topeka, KS 66612-1367. Send one copy to WATER WELL OWNER and retain one for your records.
Visit us at http://www.kdheks.gov/waterwell/index.html Telephone 785-296-5524.