

WATER WELL PLUGGING RECORD Form WWC-5P
KSA 82a-1212
ID NO.

1 LOCATION OF WATER WELL: County: <u>Barton</u>	Fraction: <u>NW 1/4 SW 1/4 SW 1/4 NW 1/4</u>	Section Number: <u>16</u>	Township Number: <u>T 19 S</u>	Range Number: <u>13</u> ☐ E ☒ W
---	--	---------------------------	--------------------------------	--

 Street/Rural Address of Well Location; if unknown, distance & direction from nearest town or intersection: If at owner's address, check here ☐ 260 N. Washington
Great Bend, KS 67530
Global Positioning Systems (GPS) information:

Latitude: _____ (in decimal degrees)

Longitude: _____ (in decimal degrees)

Elevation: _____

 Horizontal Datum: ☐ WGS84, ☐ NAD83, ☐ NAD27

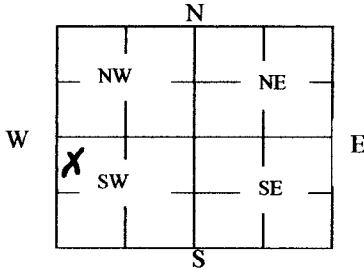
Collection Method: _____

2 WATER WELL OWNER: RR#, St. Address, Box #: <u>Carolyn Ferris</u> City, State ZIP Code: <u>PO Box 1386</u> <u>Great Bend, KS 67530</u>

☐ GPS unit (Make/Model: _____)

☐ Digital Map/Photo, ☐ Topographic Map, ☐ Land Survey

 Est. Accuracy: ☐ < 3 m, ☐ 3-5 m, ☐ 5-15 m, ☐ > 15 m

3 MARK WELL'S LOCATION WITH AN "X" IN SECTION BOX:

4 DEPTH OF WELL 96' **ft.**

 WELL'S STATIC WATER LEVEL 14' 6" **ft**

WELL WAS USED AS:

- ☒ Domestic
☐ Irrigation
☐ Feedlot
☐ Industrial

- ☐ Public Water Supply
☐ Oil Field Water Supply
☐ Domestic (Lawn & Garden)
☐ Air Conditioning

- ☐ Dewatering
☐ Monitoring
☐ Injection Well
☐ Other _____

 Was a chemical/bacteriological sample submitted to Department? Yes ☐ No ☒
5 TYPE OF BLANK CASING USED:
☐ Steel
☒ PVC

☐ RMP (SR)
☐ ABS

☐ Wrought
☐ Asbestos-Cement

☐ Fiberglass
☐ Concrete Tile

☐ Other (Specify below) _____

 Blank casing diameter 4 1/2 in. Was casing pulled? Yes ☐ No ☒ If yes, how much _____
 Casing height above or below land surface _____ in.

6 GROUT PLUG MATERIAL: ☐ Neat cement ☐ Cement grout ☒ Bentonite ☐ Other _____

 Grout Plug Intervals: From 96' ft. to 3' ft., From _____ ft. to _____ ft., From _____ ft. to _____ ft.

What is the nearest source of possible contamination:

- | | | | |
|---|---|---|--|
| ☒ Septic tank | ☐ Seepage pit | ☐ Fuel storage | ☐ Other (specify below) _____ |
| ☒ Sewer lines | ☐ Pit privy | ☐ Fertilizer storage | |
| ☐ Watertight sewer lines | ☐ Sewage lagoon | ☐ Insecticide storage | |
| ☐ Lateral lines | ☐ Feedyard | ☐ Abandoned water well | Direction from well? _____ |
| ☐ Cess pool | ☐ Livestock pens | ☐ Oil well/Gas well | How many feet? _____ |

FROM	TO	PLUGGING MATERIALS	FROM	TO	PLUGGING MATERIALS
96'	3'	3/8 chip Bentonite holeplug			
3'	0'	Compacted Soil			

7 CONTRACTOR'S OR LANDOWNER'S CERTIFICATION: This water well was plugged under my jurisdiction and was completed on (mo/day/year) 6/13/15 and this record is true to the best of my knowledge and belief. Kansas Water Well Contractor's License No. _____. This Water Well Record was completed on (mo/day/year) 12/10/15 under the business name of _____ by (signature) Carolyn Ferris

Send one white copy to Kansas Department of Health & Environment, Geology Section, 1000 SW Jackson Street, Ste. 420, Topeka, KS 66612-1367. Send one copy to WATER WELL OWNER and retain one for your records.

Visit us at <http://www.kdheks.gov/waterwell/index.html> Telephone 785-296-5524.

KSA82a-1212
Revised 1/20/2015