
KOLAR Document ID: 1365966

	WELL R			WWC-5		vision of Wat						
		Correction		e in Well Use		ources App.]			Well ID			
		ATER WEL	،L:	Fraction		ction Numb	er	Township Numb		ge Number		
County				1/4 1/4 1/4				T S	R	$\Box E \Box W$		
	OWNER: L	ast Name:		First:				ere well is located	· · ·			
Business: Address:					direction from	irection from nearest town or intersection): If at owner's address, check here:						
Address:												
City:			State:	ZIP:								
3 LOCAT	E WELL	4.00000					_					
WITH "X" IN 4 DEPTH OF COMPLETED WE								-				
SECTIO	SECTION BOX: Depth(s) Groundwater Encounter							Longitude:				
Ν	N 2)					Datum: WGS 84 NAD 83 NAD 27						
			below land surface, measured on (mo-day-yr)				Source for Latitude/Longitude:					
			above land surface, measured on (mo-day-yr)					WAAS enabled?				
			st data: Well water was ft.				Land Survey Topographic Map			.0)		
w				s pumping				e Mapper:				
	W I I I W			vater was f								
SW	SE			s pumping	6 Flow							
		Estimated Y				6 Elevation :ft. □ Ground Level □ TOC <u>Source</u> : □ Land Survey □ GPS □ Topographic Map						
	S	Bore Hole L		in. to	Source		Other					
1 n		DE LIGED		in. to	II.			Oulei	•••••			
		BE USED A		ten Consultur anall ID				14 Watan Camalan 1				
1. Domestic:				ter Supply: well ID								
				g: how many wells? echarge: well ID		11. Test Hole: well ID						
				g: well ID								
	2. □ Irrigation 9. Environmental Remedi							othermal: how many bores? Closed Loop				
3. \Box Feedlo			Air Sparge					Loop Surface Di				
4. 🗌 Industr			Recovery					(specify):				
Was a chemical/bacteriological sample submitted to KDHE ? Yes No If yes, date sample was submitted:												
						11 yes, au	ie sui	iipie was sublitte	u			
				C 🗌 Other	CASI	NG IOINTS	g. □	Gluad Clampa	U Walda	1 🗆 Thrandad		
				Diameter								
				Weight				or gauge No				
		PERFORAT			1000,10	,, un une		or gauge rior min				
□ Steel		less Steel	☐ Fiber			□ Ot	her (Specify)				
Brass		anized Steel	Conc		sed (open hol			1 57				
SCREEN C	OR PERFOR	ATION OPE			` 1	,						
Contir	nuous Slot	🗌 Mill Slot	🗌 Ga	auze Wrapped 🛛 🗌 To	orch Cut 🔲 I	Drilled Holes		Other (Specify)				
	ered Shutter	☐ Key Punch				None (Open I						
				n ft. to								
GRAVEL PACK INTERVALS: From ft. to ft., From ft. to ft., From ft., From ft. to ft.												
9 GROUT MATERIAL: Neat cement Cement grout Bentonite Other												
Grout Intervals: From ft. to ft., From ft. to ft., From ft. to ft. to ft.												
		e contaminati			_				1. 0.			
Septic '			Lateral Line Cess Pool			Livestock P			cide Storage			
				□ Sewage La □ Feedyard		Fuel Storage				wen		
□ Watertight Sewer Lines □ Seepage Pit □ Feedyard □ Fertilizer Storage □ Oil Well/Gas Well □ Other (Specify)												
Direction from well?												
10 FROM	TO		ITHOLOG		FROM	ТО		HO. LOG (cont.) or		GINTERVALS		
		-										
	<u> </u>											
					Notes:	1	1					
11 CONT	RACTOR'S	OR LANDO	WNER'S	S CERTIFICATION	I: This wate	er well was		onstructed, \Box reco	onstructed.	or 🗌 plugged		
under my ju	urisdiction an	nd was compl	eted on (n	no-day-year)	and	this record	is tru	ie to the best of m	y knowled	ge and belief.		
Kansas Wa	ter Well Cor	tractor's Lice	ense No	This Wa	ater Well Re	cord was co	mple	eted on (mo-day-ye	ear)			
under the b	usiness name	<u>e of</u>			<u></u>							
KS Donorte				ELL OWNER and retain of Vater, Geology Section, 10						785-206 3565		
		ks.gov/waterwel		ater, Geology Section, 10	JUD D IV JACKSOI	i 51., 5uite 420	, 10pt			A 82a-1212		

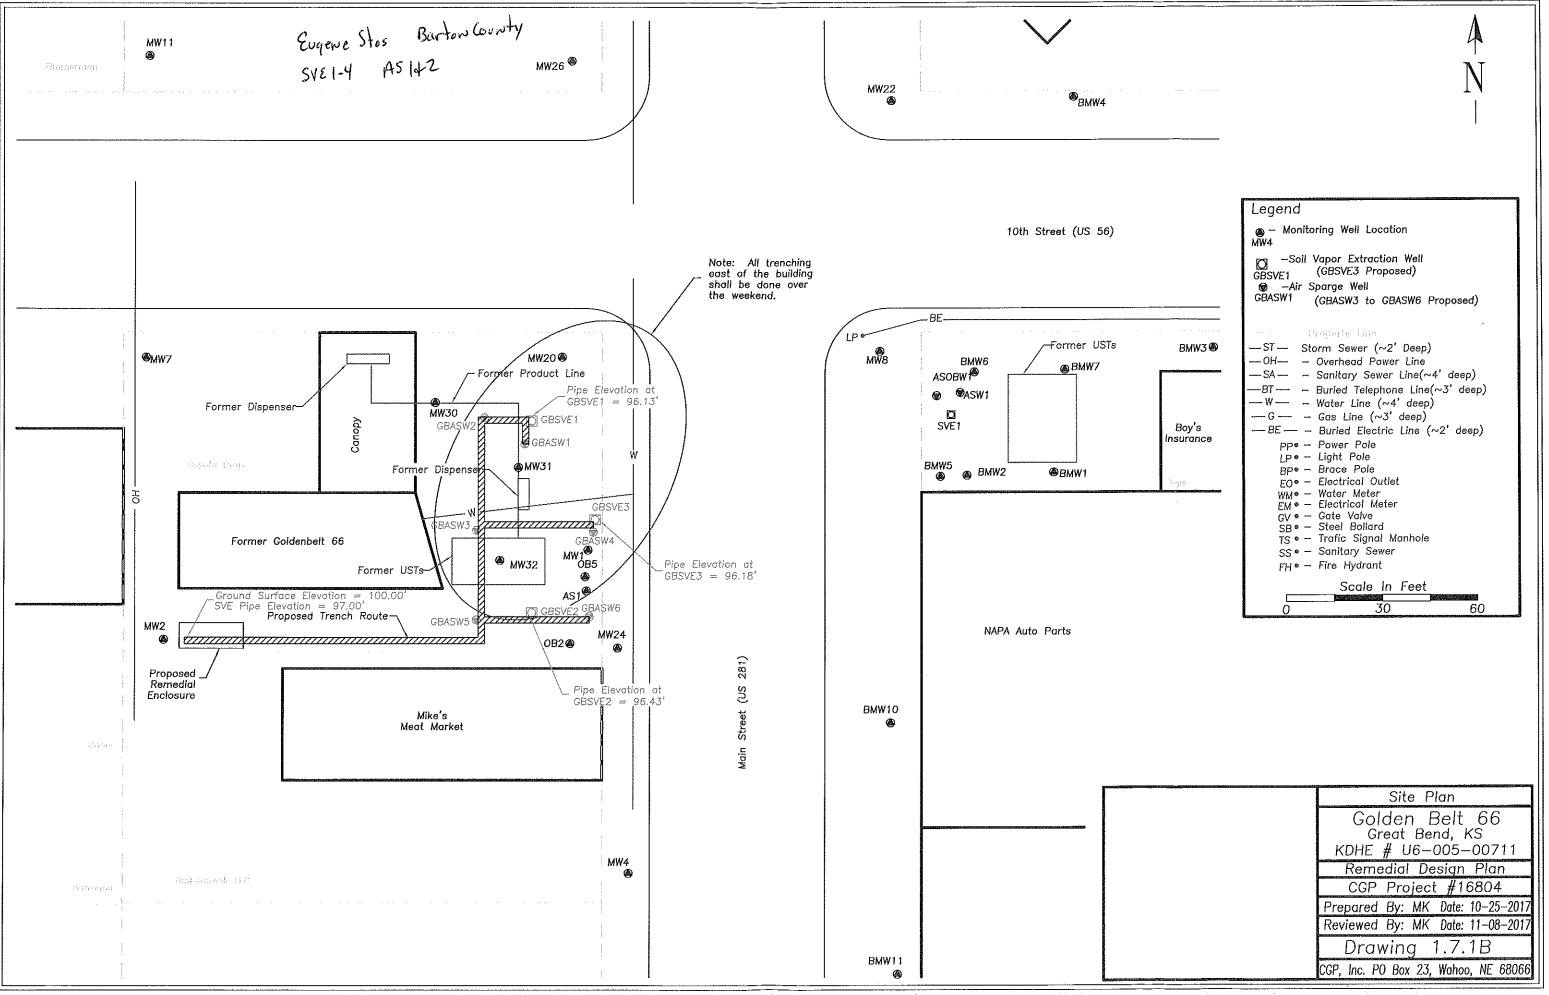

	Site Plan
	Golden Belt 66 Great Bend, KS
	KDHE # U6-005-00711
	Remedial Design Plan
	CGP Project #16804
	Prepared By: MK Date: 10-25-2017
	Reviewed By: MK Date: 11–08–2017
	Drawing 1.7.1B
Converse and a second secon	CGP, Inc. PO Box 23, Wahoo, NE 68066