


1 LOCATION OF WATER WELL: Fraction NW 1/4 NW 1/4 NE 1/4 SW 1/4 Section Number 33 Township Number T 19 S Range Number 13 E W
 County: Barton

Street/Rural Address of Well Location; if unknown, distance & direction from nearest town or intersection: If at owner's address, check here
2315 Railroad Avenue, Great Bend, Kansas

Global Positioning Systems (GPS) information:
 Latitude: 38.3540 (in decimal degrees)
 Longitude: -98.7696 (in decimal degrees)
 Elevation: 1851 ft
 Datum: WGS84, NAD83, NAD27
 Collection Method:
 GPS unit (Make/Model): _____
 Digital Map/Photo, Topographic Map, Land Survey
 Est. Accuracy: < 3 m, 3-5 m, 5-15 m, > 15 m

2 WATER WELL OWNER: Exxon Corp Property
 RR#, St. Address, Box #: PO Box 64106
 City, State ZIP Code: Spring, TX 77387-4106

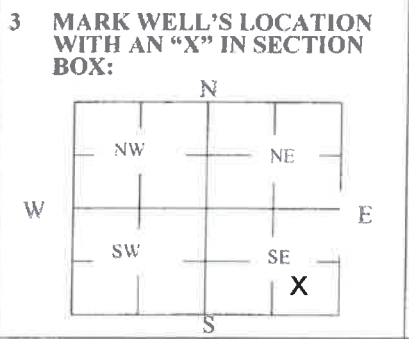

4 DEPTH OF WELL 22.15 ft.
WELL'S STATIC WATER LEVEL 11.19 ft
WELL WAS USED AS:
 Domestic
 Irrigation
 Feedlot
 Industrial
 Public Water Supply
 Oil Field Water Supply
 Domestic (Lawn & Garden)
 Air Conditioning
 Dewatering
 Monitoring
 Injection Well
 Other _____
 Was a chemical/bacteriological sample submitted to Department? Yes No

5 TYPE OF BLANK CASING USED:
 Steel RMP (SR) Wrought Fiberglass Other (Specify below)
 PVC ABS Asbestos-Cement Concrete Tile
 Blank casing diameter 5 in. Was casing pulled? Yes No If yes, how much 3 feet
 Casing height above or below land surface _____ in.

6 GROUT PLUG MATERIAL: Neat cement Cement grout Bentonite Other _____
 Grout Plug Intervals: From 10.19 ft. to 0 ft., From _____ ft. to _____ ft., From _____ ft. to _____ ft.
 What is the nearest source of possible contamination:
 Septic tank Seepage pit Fuel storage Other (specify below)
 Sewer lines Pit privy Fertilizer storage
 Watertight sewer lines Sewage lagoon Insecticide storage
 Lateral lines Feedyard Abandoned water well Direction from well? _____
 Cess pool Livestock pens Oil well/Gas well How many feet? _____

| FROM | TO | PLUGGING MATERIALS | FROM | TO | PLUGGING MATERIALS |
|-------|-------|--------------------|-------|----|--------------------|
| 22.15 | 10.19 | 10-20 Sand | 10.19 | 0 | Bentonite |
| | | | | | |
| | | | | | |
| | | | | | |
| | | | | | |

7 CONTRACTOR'S OR LANDOWNER'S CERTIFICATION: This water well was plugged under my jurisdiction and was completed on (mo/day/year) 05/08/2018 and this record is true to the best of my knowledge and belief. Kansas Water Well Contractor's License No. 727. This Water Well Record was completed on (mo/day/year) 05/25/2018 under the business name of Vista Geoscience by (signature) [Signature]

INSTRUCTIONS: Use typewriter or ballpoint pen. Please press firmly and print clearly. Please fill in blanks, underline or circle the correct answers. Send top three copies to Kansas Department of Health and Environment, Bureau of Water, Geology Section, 1000 SW Jackson St., Ste. 420, Topeka, Kansas 66612-1367. Telephone: 785/296-5524. Send one to Water Well Owner and retain one for your records. Visit us at <http://www.kdheks.gov/waterwell/index.html>.

Digitally signed by John V. Fontana
 DN: cn=John V. Fontana, o=Vista Geoscience, LLC
 Date: 2018.05.30 12:30:32 -0500