

**1 LOCATION OF WATER WELL:**      Fraction NW 1/4 NW 1/4 NE 1/4 SW 1/4      Section Number 33      Township Number T 19 S      Range Number 13       E       W

County: Barton

Street/Rural Address of Well Location; if unknown, distance & direction from nearest town or intersection: If at owner's address, check here


**2309 Railroad Avenue, Great Bend, Kansas**

**Global Positioning Systems (GPS) information:**  
 Latitude: 38.3539 (in decimal degrees)  
 Longitude: -98.7691 (in decimal degrees)  
 Elevation: 1853 ft  
 Datum:  WGS84,     NAD83,     NAD27  
 Collection Method:

**2 WATER WELL OWNER:** Exxon Corp Property  
 RR#, St. Address, Box #: PO Box 64106  
 City, State ZIP Code: Spring, TX 77387-4106

GPS unit (Make/Model):  
 Digital Map/Photo.     Topographic Map,     Land Survey

Est. Accuracy:  < 3 m,     3-5 m,     5-15 m,     > 15 m

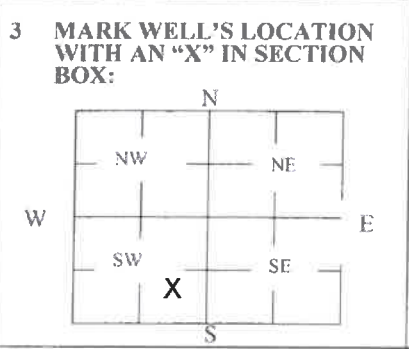

**4 DEPTH OF WELL** 17.45 ft.  
**WELL'S STATIC WATER LEVEL** 8.28 ft  
**WELL WAS USED AS:**

Domestic                       Public Water Supply                       Dewatering  
 Irrigation                       Oil Field Water Supply                       Monitoring  
 Feedlot                           Domestic (Lawn & Garden)                       Injection Well  
 Industrial                       Air Conditioning                           Other \_\_\_\_\_

Was a chemical/bacteriological sample submitted to Department? Yes  No

**5 TYPE OF BLANK CASING USED:**

Steel     RMP (SR)     Wrought     Fiberglass     Other (Specify below)  
 PVC     ABS     Asbestos-Cement     Concrete Tile

Blank casing diameter 4 in.    Was casing pulled? Yes  No     If yes, how much 3 feet  
 Casing height above or below land surface \_\_\_\_\_ in.

**6 GROUT PLUG MATERIAL:**     Neat cement     Cement grout     Bentonite     Other \_\_\_\_\_

Grout Plug Intervals:    From 7.28 ft. to 0 ft.,    From \_\_\_\_\_ ft. to \_\_\_\_\_ ft.,    From \_\_\_\_\_ ft. to \_\_\_\_\_ ft.

What is the nearest source of possible contamination:

Septic tank                       Seepage pit                       Fuel storage                       Other (specify below)  
 Sewer lines                       Pit privy                           Fertilizer storage  
 Watertight sewer lines                       Sewage lagoon                       Insecticide storage  
 Lateral lines                       Feedyard                           Abandoned water well                      Direction from well? \_\_\_\_\_  
 Cess pool                           Livestock pens                       Oil well/Gas well                      How many feet? \_\_\_\_\_

FROM	TO	PLUGGING MATERIALS	FROM	TO	PLUGGING MATERIALS
17.45	7.28	10-20 Sand	7.28	0	Bentonite

**7 CONTRACTOR'S OR LANDOWNER'S CERTIFICATION:** This water well was plugged under my jurisdiction and was completed on (mo/day/year) 05/08/2018 and this record is true to the best of my knowledge and belief. Kansas Water Well Contractor's License No. 727. This Water Well Record was completed on (mo/day/year) 05/25/2018 under the business name of Vista Geoscience by (signature) \_\_\_\_\_

Digitally signed by John V. Fontana  
 DN: cn=John V. Fontana, ou=Vista Geoscience, LLC  
 ou=Vista Geoscience, email=jfontana@vistageo.com, c=US  
 Date: 2018.05.30 12:19:20 -0600

**INSTRUCTIONS:** Use typewriter or ballpoint pen. Please press firmly and print clearly. Please fill in blanks, underline or circle the correct answers. Send top three copies to Kansas Department of Health and Environment, Bureau of Water, Geology Section, 1000 SW Jackson St., Ste. 420, Topeka, Kansas 66612-1367. Telephone: 785/296-5524. Send one to Water Well Owner and retain one for your records. Visit us at <http://www.kdheks.gov/waterwell/index.html>.