

WATER WELL RECORD Form WWC-5


Original Record Correction Change in Well Use

Division of Water Resources App. No.

Well ID Yard

1 LOCATION OF WATER WELL: County: Barton	Fraction NE ¼ NE ¼ SW ¼ NE ¼	Section Number 5	Township Number T 19 S	Range Number R 13 <input type="checkbox"/> E <input checked="" type="checkbox"/> W
--	---------------------------------	---------------------	---------------------------	---

2 WELL OWNER: Last Name: Durrett First: Robin Business: _____ Address: 31 NW 48 Rd. Address: _____ City: Great Bend State: KS ZIP: 67530	Street or Rural Address where well is located (if unknown, distance and direction from nearest town or intersection): _____ If at owner's address, check here: <input checked="" type="checkbox"/>
---	---

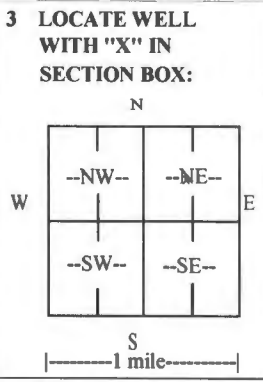

4 DEPTH OF COMPLETED WELL: 100 ft.

Depth(s) Groundwater Encountered: 1) _____ ft.
2) _____ ft. 3) _____ ft., or 4) Dry Well

WELL'S STATIC WATER LEVEL: 34.15 ft.

below land surface, measured on (mo-day-yr) 11-06-18
 above land surface, measured on (mo-day-yr) _____

Pump test data: Well water was not checked ft.
after _____ hours pumping _____ gpm
Well water was _____ ft.
after _____ hours pumping _____ gpm

Estimated Yield: _____ gpm
Bore Hole Diameter: 9 in. to 100 ft. and _____ in. to _____ ft.

5 Latitude: 38.430365 (decimal degrees)
Longitude: -98.779948 (decimal degrees)
Horizontal Datum: WGS 84 NAD 83 NAD 27
Source for Latitude/Longitude:
 GPS (unit make/model: _____ (WAAS enabled? Yes No)
 Land Survey Topographic Map
 Online Mapper: _____

6 Elevation: Unknown ft. Ground Level TOC
Source: Land Survey GPS Topographic Map
 Other: _____

7 WELL WATER TO BE USED AS:

1. Domestic: <input type="checkbox"/> Household <input checked="" type="checkbox"/> Lawn & Garden <input type="checkbox"/> Livestock	5. <input type="checkbox"/> Public Water Supply: well ID _____ 6. <input type="checkbox"/> Dewatering: how many wells? _____ 7. <input type="checkbox"/> Aquifer Recharge: well ID _____ 8. <input type="checkbox"/> Monitoring: well ID _____ 9. Environmental Remediation: well ID _____ <input type="checkbox"/> Air Sparge <input type="checkbox"/> Soil Vapor Extraction <input type="checkbox"/> Recovery <input type="checkbox"/> Injection	10. <input type="checkbox"/> Oil Field Water Supply: lease _____ 11. Test Hole: well ID _____ <input type="checkbox"/> Cased <input type="checkbox"/> Uncased <input type="checkbox"/> Geotechnical 12. Geothermal: how many bores? a) Closed Loop <input type="checkbox"/> Horizontal <input type="checkbox"/> Vertical b) Open Loop <input type="checkbox"/> Surface Discharge <input type="checkbox"/> Inj. of Water 13. <input type="checkbox"/> Other (specify): _____
2. <input type="checkbox"/> Irrigation	3. <input type="checkbox"/> Feedlot	4. <input type="checkbox"/> Industrial

Was a chemical/bacteriological sample submitted to KDHE? Yes No If yes, date sample was submitted: _____
Water well disinfected? Yes No

8 TYPE OF CASING USED: Steel PVC CASING JOINTS: Glued Clamped Welded Threaded Other _____
Casing diameter 5 in. to 78 ft., Diameter _____ in. to _____ ft., Diameter _____ in. to _____ ft.
Casing height above land surface 24 in. Weight 2.36 lbs./ft. Wall thickness or gauge No. 215

TYPE OF SCREEN OR PERFORATION MATERIAL:
 Steel Stainless Steel Fiberglass PVC Other (Specify) _____
 Brass Galvanized Steel Concrete tile None used (open hole)

SCREEN OR PERFORATION OPENINGS ARE:
 Continuous Slot Mill Slot Gauze Wrapped Torch Cut Drilled Holes Other (Specify) _____
 Louvered Shutter Key Punched Wire Wrapped Saw Cut None (Open Hole)

SCREEN-PERFORATED INTERVALS: From 78 ft. to 98 ft., From _____ ft. to _____ ft., From _____ ft. to _____ ft.
GRAVEL PACK INTERVALS: From 24 ft. to 100 ft., From _____ ft. to _____ ft., From _____ ft. to _____ ft.

9 GROUT MATERIAL: Neat cement Cement grout Bentonite Other _____
Grout Intervals: From 0 ft. to 24 ft., From _____ ft. to _____ ft., From _____ ft. to _____ ft.

Nearest source of possible contamination:
 Septic Tank Lateral Lines Pit Privy Livestock Pens Insecticide Storage
 Sewer Lines Cess Pool Sewage Lagoon Fuel Storage Abandoned Water Well
 Watertight Sewer Lines Seepage Pit Feedyard Fertilizer Storage Oil Well/Gas Well
 Other (Specify) _____
Direction from well? Northeast Distance from well? 135 ft.

10 FROM	TO	LITHOLOGIC LOG	FROM	TO	LITHO. LOG (cont.) or PLUGGING INTERVALS
0	4	Topsoil	96	100	Shale, dark gray
4	9	Clay, dark brown			
9	23	Clay, brown			
23	33	Clay, tan			
33	41	Sand, fine to very fine			
41	52	Clay, gray			
52	57	Sand, very fine to fine			
57	77	Clay, brown			
77	96	Sandstone			

Notes:

11 CONTRACTOR'S OR LANDOWNER'S CERTIFICATION: This water well was constructed, reconstructed, or plugged under my jurisdiction and was completed on (mo-day-year) 11-06-18 and this record is true to the best of my knowledge and belief.
Kansas Water Well Contractor's License No. 185 This Water Well Record was completed on (mo-day-year) 11-09-18
under the business name of Clarke Well & Equipment, Inc. Signature _____