

Well #3

WATER WELL RECORD Form WWC-5

Division of Water Resources App. No.


20180258

Well ID

Original Record Correction Change in Well Use

1 LOCATION OF WATER WELL: County: Barton Fraction 1/4 SE 1/4 NW 1/4 NW 1/4 Section Number 32 Township Number T 19 S Range Number R 13 E W

2 WELL OWNER: Last Name: City of Great Bend First: Street or Rural Address where well is located: 8th & Grant, Great Bend

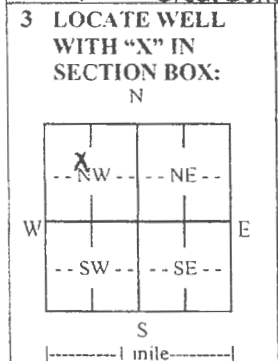

4 DEPTH OF COMPLETED WELL: 40 ft. Depth(s) Groundwater Encountered: 1) 9 1/2 ft. WELL'S STATIC WATER LEVEL: 9 1/2 ft.

5 Latitude: Longitude: Horizontal Datum: WGS 84 NAD 83 NAD 27 Source for Latitude/Longitude: GPS Land Survey Topographic Map Online Mapper

7 WELL WATER TO BE USED AS: 1. Domestic: Household Lawn & Garden Livestock 2. Irrigation 3. Feedlot 4. Industrial

Was a chemical/bacteriological sample submitted to KDHE? Yes No If yes, date sample was submitted:

8 TYPE OF CASING USED: Steel PVC Other CASING JOINTS: Glued Clamped Welded Threaded Casing diameter 8 in. to 40 ft. Diameter 18 in. Weight SDR-26 lbs./ft. Wall thickness or gauge No.

9 GROUT MATERIAL: Neat cement Cement grout Bentonite Other Grout Intervals: From 10 ft. to 0 ft. Nearest source of possible contamination: Septic Tank Sewer Lines Watertight Sewer Lines Other

Table with 6 columns: 10 FROM, TO, LITHOLOGIC LOG, FROM, TO, LITHO. LOG (cont.) or PLUGGING INTERVALS. Rows include Top soil, Clay, Sand & gravel- med to large, Brown & gray clay.

11 CONTRACTOR'S OR LANDOWNER'S CERTIFICATION: This water well was constructed, reconstructed, or plugged under my jurisdiction and was completed on (mo-day-year) 11-1-18 and this record is true to the best of my knowledge and belief.