

WATER WELL RECORD Form WWC-5


Division of Water Resources App. No.

Well ID Domestic

Original Record Correction Change in Well Use

1 LOCATION OF WATER WELL: County: Barton Fraction NE 1/4 NW 1/4 NE 1/4 NE 1/4 Section Number 28 Township Number T 19 S Range Number R 13 E W

2 WELL OWNER: Last Name: Business: M & D Properties, LLC Address: P.O. Box 1783 City: Great Bend State: KS ZIP: 67530 Street or Rural Address where well is located: Located at 2316 Heizer in Great Bend.

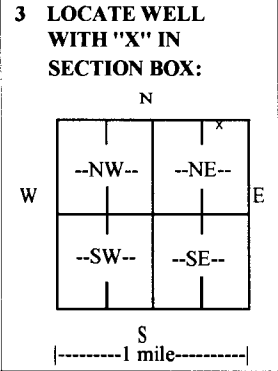

3 LOCATE WELL WITH 'X' IN SECTION BOX: 4 DEPTH OF COMPLETED WELL: 37 ft. Depth(s) Groundwater Encountered: 1) ft. 2) ft. 3) ft., or 4) Dry Well WELL'S STATIC WATER LEVEL: 5.70 ft. below land surface, measured on (mo-day-yr) 05-30-19

5 Latitude: 38.375544 (decimal degrees) Longitude: -98.757836 (decimal degrees) Horizontal Datum: WGS 84 NAD 83 NAD 27 Source for Latitude/Longitude: GPS (unit make/model): (WAAS enabled? Yes No) Land Survey Topographic Map Online Mapper:

6 Elevation: Unknown ft. Ground Level TOC Source: Land Survey GPS Topographic Map Other

7 WELL WATER TO BE USED AS: 1. Domestic: Household Lawn & Garden Livestock Irrigation Feedlot Industrial 2. Public Water Supply: well ID Dewatering: how many wells? Aquifer Recharge: well ID Monitoring: well ID Environmental Remediation: well ID Air Sparge Soil Vapor Extraction Recovery Injection Oil Field Water Supply: lease Test Hole: well ID Cased Uncased Geotechnical Geothermal: how many bores? a) Closed Loop Horizontal Vertical b) Open Loop Surface Discharge Inj. of Water Other (specify):

Was a chemical/bacteriological sample submitted to KDHE? Yes No If yes, date sample was submitted: Water well disinfected? Yes No

8 TYPE OF CASING USED: Steel PVC CASING JOINTS: Glued Clamped Welded Threaded Other Casing diameter 5 in. to 25 ft., Diameter in. to ft., Diameter in. to ft. Casing height above land surface 24 in. Weight 2.36 lbs./ft. Wall thickness or gauge No. .215 TYPE OF SCREEN OR PERFORATION MATERIAL: Steel Stainless Steel Fiberglass PVC Other (Specify) SCREEN OR PERFORATION OPENINGS ARE: Continuous Slot Mill Slot Gauze Wrapped Torch Cut Drilled Holes Other (Specify) Louvered Shutter Key Punched Wire Wrapped Saw Cut None (Open Hole) SCREEN-PERFORATED INTERVALS: From 25 ft. to 35 ft., From ft. to ft., From ft. to ft. GRAVEL PACK INTERVALS: From 20 ft. to 40 ft., From ft. to ft., From ft. to ft.

9 GROUT MATERIAL: Neat cement Cement grout Bentonite Other Grout Intervals: From 0 ft. to 20 ft., From ft. to ft., From ft. to ft.

Nearest source of possible contamination: Septic Tank Lateral Lines Pit Privy Livestock Pens Insecticide Storage Sewer Lines Cess Pool Sewage Lagoon Fuel Storage Abandoned Water Well Watertight Sewer Lines Seepage Pit Feedyard Fertilizer Storage Oil Well/Gas Well Other (Specify) None Known Direction from well? Distance from well? ft.

Table with columns: FROM, TO, LITHOLOGIC LOG, FROM, TO, LITHO. LOG (cont.) or PLUGGING INTERVALS. Rows: 0-4 Topsoil, 4-13 Clay, dark brown, 13-40 Sand & gravel, fine to medium. Includes a Notes section.

11 CONTRACTOR'S OR LANDOWNER'S CERTIFICATION: This water well was constructed, reconstructed, or plugged under my jurisdiction and was completed on (mo-day-year) 05-30-19 and this record is true to the best of my knowledge and belief. Kansas Water Well Contractor's License No. 185 This Water Well Record was completed on (mo-day-year) 06-03-19 under the business name of Clarke Well & Equipment, Inc. Signature