

County: Barton Fraction: SE SE SE SE Sec. 20 T. 19 S R. 13 W

CORRECTION(S) to WATER WELL COMPLETION RECORD Form WWC-5 (to rectify lacking or incorrect information)

Owner: Presto 18 MW 16

If location corrected, was listed as:

Section-Township-Range: 29-19-13W

Fraction (1/4 calls): SE SE NE

Location changed to:

20-19-13W

SE SE SE SE

Other changes: Initial statements: _____


Changed to: Elevation 1851.44

Comments: _____

Verification method: Per Carlson's Surveying Mapping survey & memorandum from KDHE 12-01-2019

Initials: SH Date: 04-22-2020

Submitted by: ☒ Kansas Geological Survey, Data Resources Library, 1930 Constant Ave., Lawrence, KS 66047-3724
☐ Kansas Dept. of Health & Environment, Bureau of Water, 1000 SW Jackson, Suite 420, Topeka, KS 66612-1367

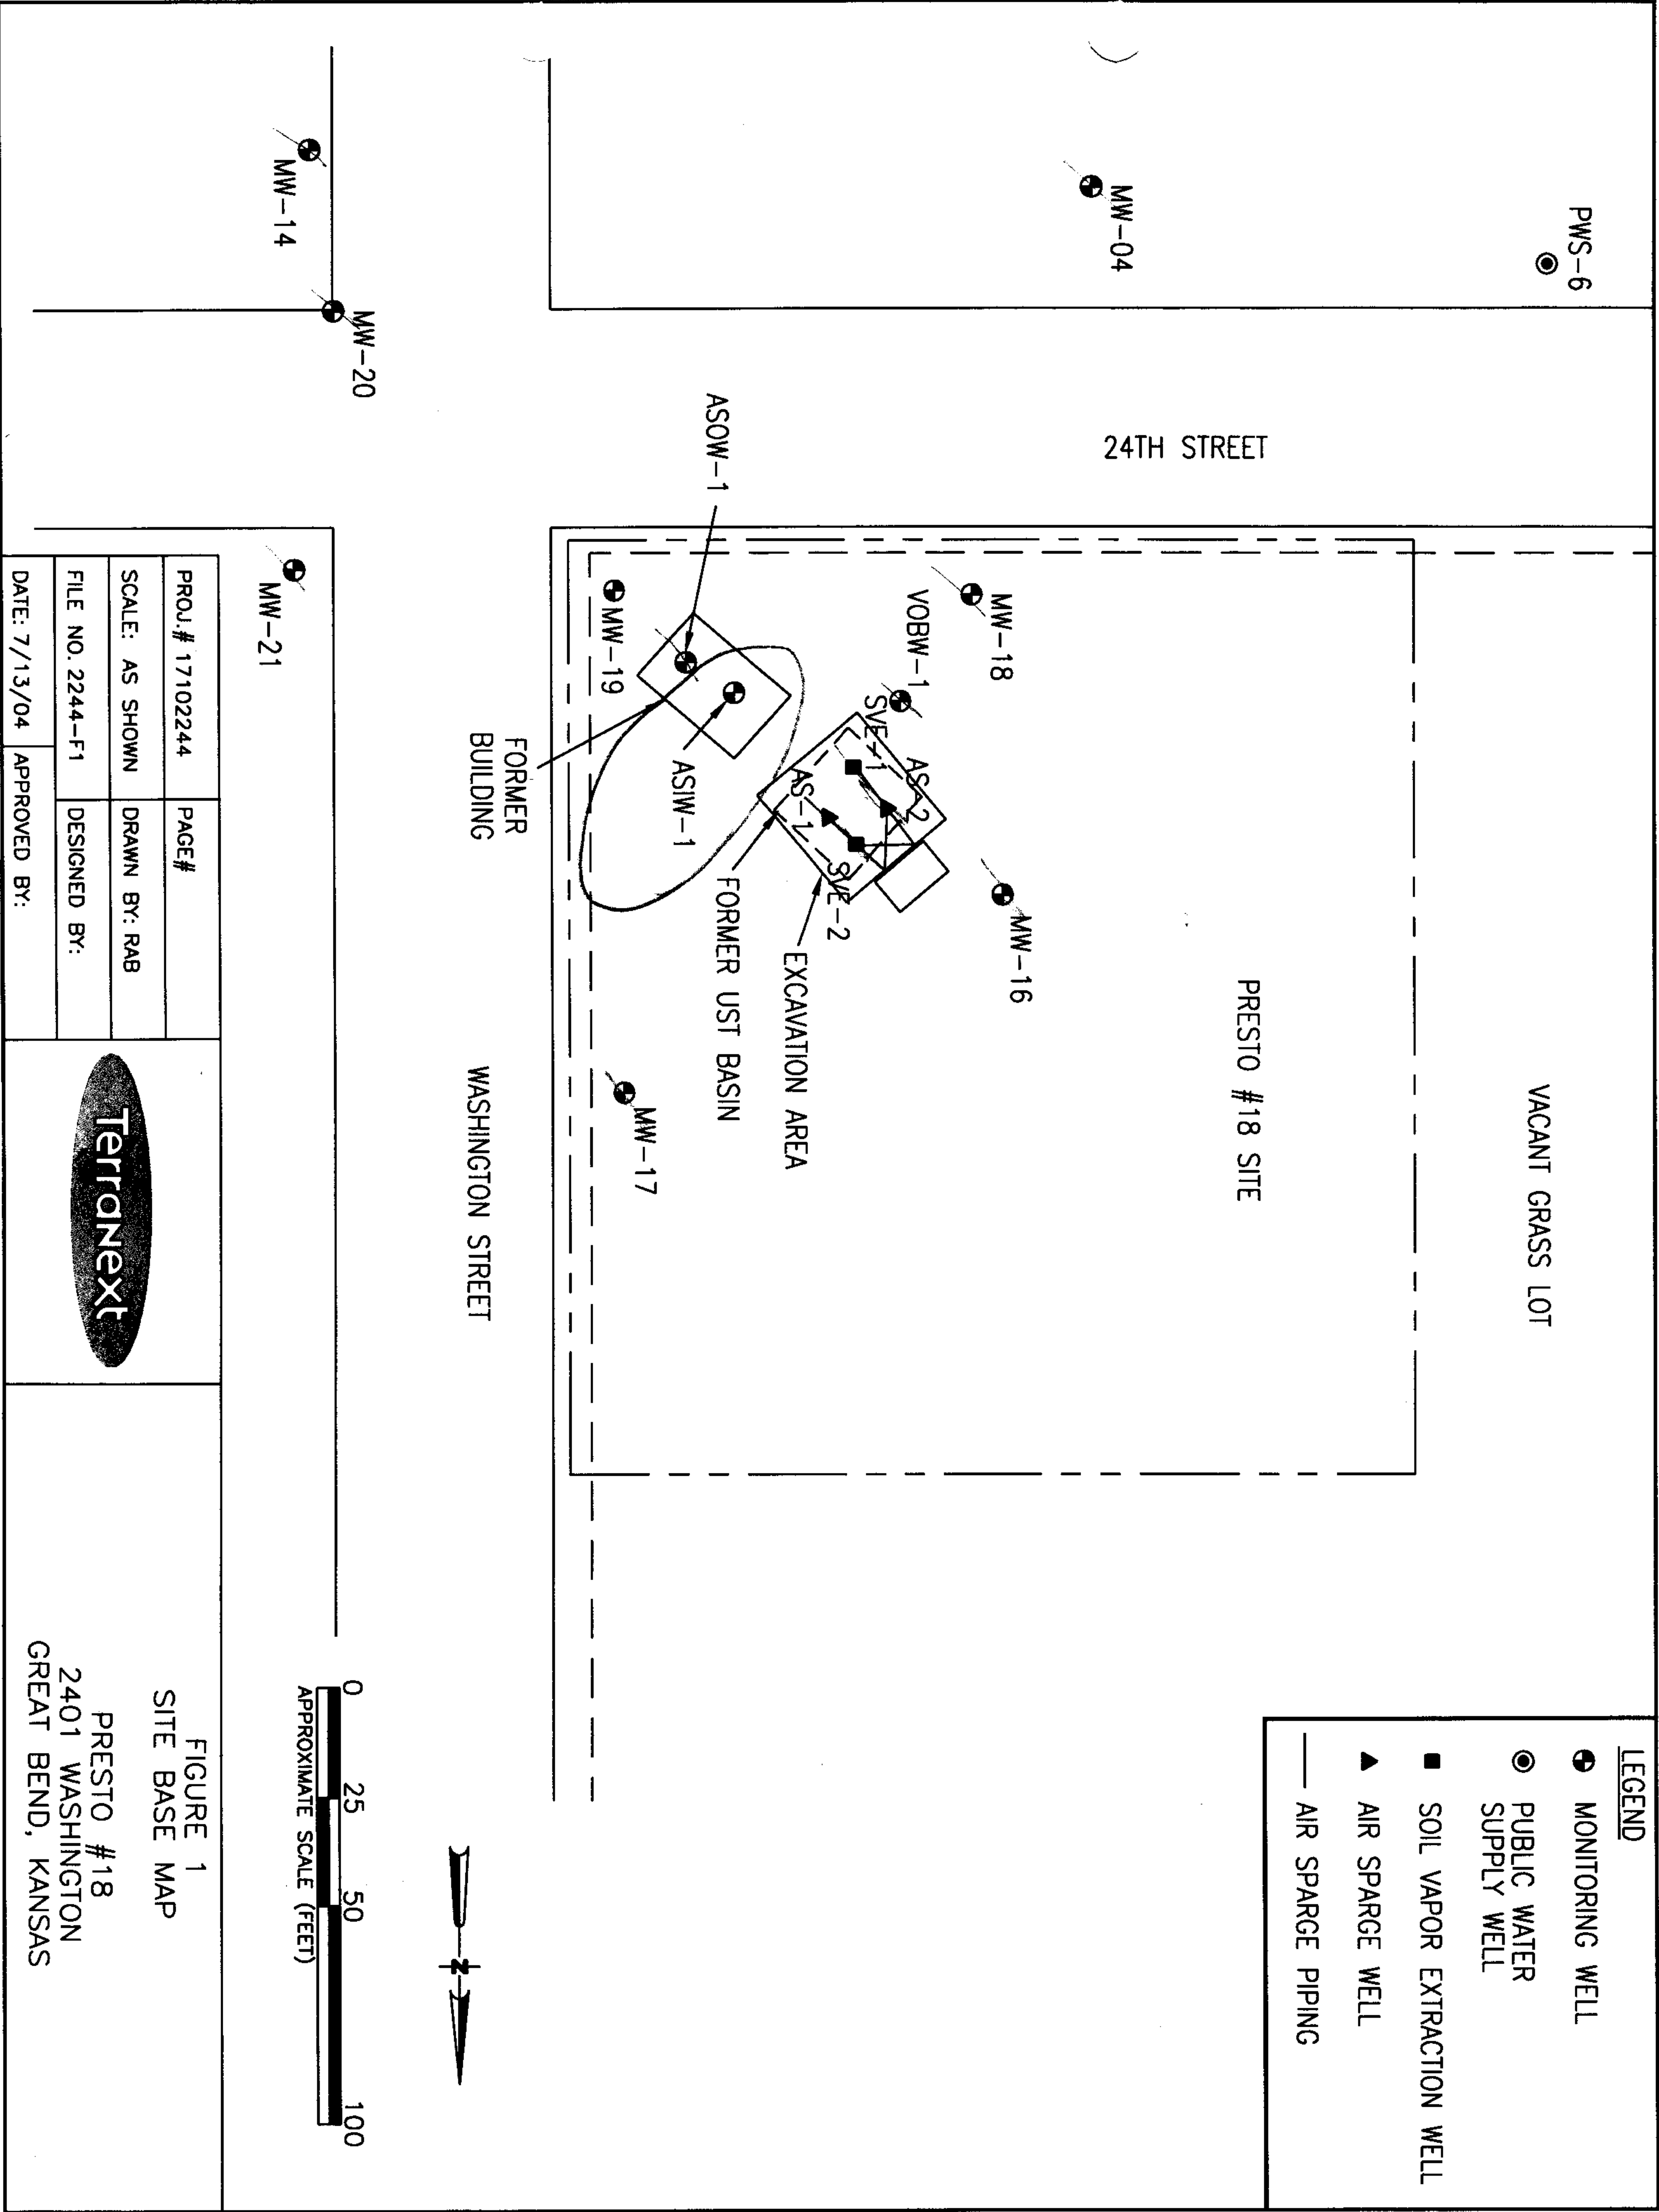

1631 200th Ave.
P.O. Box 1393
Hays, Kansas 67601
(785) 628-3219
(785) 628-2132 Fax
(785) 623-1555 Mobile
E-mail carlson@odsys.net

EVERGREEN ENVIRONMENTAL SERVICES, INC.
10553 Rene
Lenexa, Kansas 66215

March 4, 1998
#8822
page 1 of 1

SURVEYING FOR MONITORING WELLS
PRESTO #18, GREAT BEND, BARTON COUNTY, KANSAS

Surveys

Land

Wells were surveyed using the existing control point on site.

Environmental

ALTA

Topography

Architectural

Platting

Construction

Preliminary

Staking

As-builts

Mapping

Site Plans


Utilities

Contours

ADDITIONAL WELLS

#	NORTH	WEST	LATITUDE D M S	LONGITUDE D M S	ELEVATION
MW 15	5405.99	105.91	38-22-37	98-46-27	1852.34 BOLT
SE-SE-SE-SE	103.85				1851.18 TOC
MW 16	5431.39	164.35	38-22-37	98-46-28	1851.67 BOLT
SE-SE-SE-SE	129.25				1851.44 TOC
MW 17	5460.84	43.22	38-22-37	98-46-27	1852.27 BOLT
SE-SE-SE-SE	158.70				1851.77 TOC
MW 18	5356.44	121.21	38-22-36	98-46-28	1851.92 BOLT
SE-SE-SE-SE	54.30				1851.67 TOC
MW 19	5360.95	52.18	38-22-36	98-46-27	1852.16 BOLT
SE-SE-SE-SE	58.81				1851.30 TOC

NOTE: Wells are in Sec 20 T19S R13W.

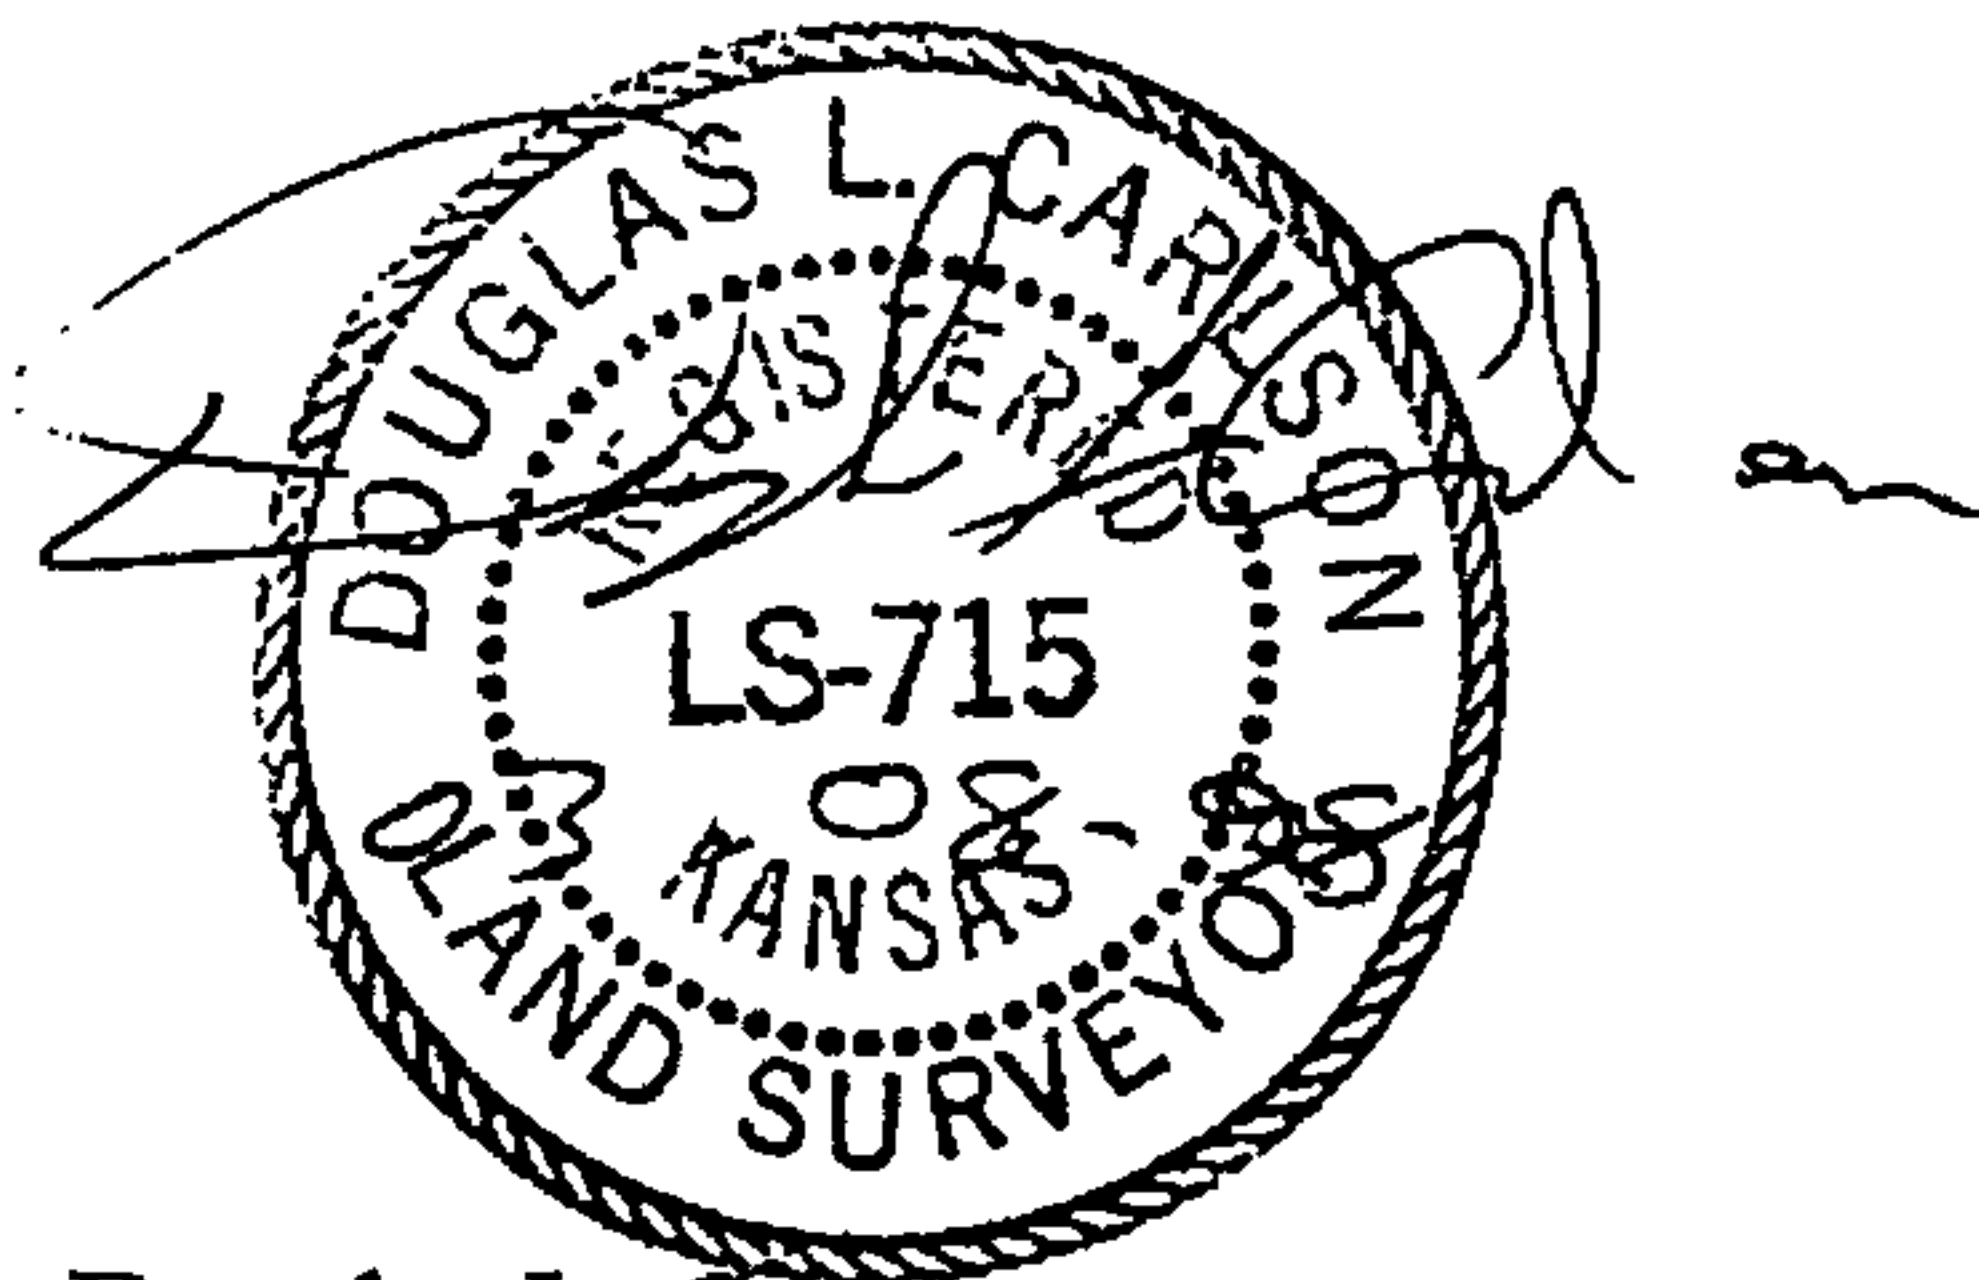

Douglas L. Carlson
Kansas Reg. No. 715