

County: Barton Fraction: SE SE SE SE Sec. 20 T. 19 S R. 13 W

CORRECTION(S) to WATER WELL COMPLETION RECORD Form WWC-5 (to rectify lacking or incorrect information)

Owner: Presto 18 MW 19

If location corrected, was listed as:

Section-Township-Range: 29-19-13W

Fraction (1/4 calls): SE SE SE

Location changed to:

20-19-13W

SE SE SE SE

Other changes: Initial statements: _____

Changed to: Elevation 1852.16

Comments: _____


Verification method: Per Carlson's Surveying Mapping survey & memorandum from KDHE 12-01-2019

Initials: SH Date: 04-22-2020

Submitted by: ☒ Kansas Geological Survey, Data Resources Library, 1930 Constant Ave., Lawrence, KS 66047-3724
☐ Kansas Dept. of Health & Environment, Bureau of Water, 1000 SW Jackson, Suite 420, Topeka, KS 66612-1367

1 LOCATION OF WATER WELL: County: <u>Barton</u>		Fraction <u>SE</u> $\frac{1}{4}$ <u>SE</u> $\frac{1}{4}$ <u>NE</u> $\frac{1}{4}$	Section Number <u>29</u>	Township Number T <u>19</u> S	Range Number R <u>13</u> E/W <u>(W)</u>	
Distance and direction from nearest town or city street address of well if located within city?	
2 WATER WELL OWNER: <u>Presto #18</u> TR#, St. Address, Box #: <u>2401 Washington</u> City, State, ZIP Code: <u>Great Bend, KS</u> Board of Agriculture, Division of Water Resources Application Number: <u>MW 19</u>	
3 LOCATE WELL'S LOCATION WITH AN "X" IN SECTION BOX: N -- NW -- NE -- W X E -- SW -- SE -- S		4 DEPTH OF COMPLETED WELL <u>16.92</u> ft. ELEVATION: <u>1851.30</u> Depth(s) Groundwater Encountered 1. ft. 2. ft. 3. ft. WELL'S STATIC WATER LEVEL <u>12.18</u> ft. below land surface measured on mo/day/yr <u>2/24/98</u> Pump test data: Well water was ft. after hours pumping gpm Est. Yield gpm: Well water was ft. after hours pumping gpm Bore Hole Diameter <u>8</u> in. to ft., and in. to ft. WELL WATER TO BE USED AS: 5 Public water supply 8 Air conditioning 11 Injection well 1 Domestic 3 Feedlot 6 Oil field water supply 9 Dewatering 12 Other (Specify below) 2 Irrigation 4 Industrial 7 Lawn and garden only <u>10 Monitoring well</u> Was a chemical/bacteriological sample submitted to Department? Yes.....No.....; If yes, mo/day/yr sample was submitted Water Well Disinfected? Yes <u>No</u>	
5 TYPE OF BLANK CASING USED: 1 Steel 3 RMP (SR) 5 Wrought iron 8 Concrete tile CASING JOINTS: Glued Clamped <u>2 PVC</u> 4 ABS 6 Asbestos-Cement 9 Other (specify below) Welded Blank casing diameter <u>2</u> in. to ft., Dia. in. to ft., Dia. in. to ft. Casing height above land surface <u>0.86</u> in., weight lbs./ft. Wall thickness or gauge No. TYPE OF SCREEN OR PERFORATION MATERIAL: <u>7 PVC</u> 10 Asbestos-cement 1 Steel 3 Stainless steel 5 Fiberglass 8 RMP (SR) 11 Other (specify) 2 Brass 4 Galvanized steel 6 Concrete tile 9 ABS 12 None used (open hole) SCREEN OR PERFORATION OPENINGS ARE: 1 Continuous slot <u>3 Mill slot</u> 5 Gauzed wrapped 8 Saw cut 11 None (open hole) 2 Louvered shutter 4 Key punched 6 Wire wrapped 9 Drilled holes SCREEN-PERFORATED INTERVALS: From <u>17'</u> ft. to <u>7'</u> ft., From ft. to ft. GRAVEL PACK INTERVALS: From <u>17'</u> ft. to <u>7'</u> ft., From ft. to ft. GROUT MATERIAL: 1 Neat cement <u>2 Cement grout</u> <u>3 Bentonite</u> 4 Other Grout intervals: From <u>7</u> ft. to <u>5</u> ft., From <u>5</u> ft. to <u>0</u> ft., From ft. to ft. What is the nearest source of possible contamination: 1 Septic tank 4 Lateral lines 7 Pit privy 10 Livestock pens 14 Abandoned water well 2 Sewer lines 5 Cess pool 8 Sewage lagoon <u>11 Fuel storage</u> 15 Oil well/Gas well 3 Watertight sewer lines 6 Seepage pit 9 Feedyard 12 Fertilizer storage 16 Other (specify below) 13 Insecticide storage Direction from well? How many feet? <table border="1" style="width:100%"><thead><tr><th>FROM</th><th>TO</th><th>LITHOLOGIC LOG</th><th>FROM</th><th>TO</th><th>PLUGGING INTERVALS</th></tr></thead><tbody><tr><td></td><td></td><td><u>Grass surface</u></td><td></td><td></td><td></td></tr><tr><td><u>0</u></td><td><u>5</u></td><td><u>Clay, silty, gray-brown, fine moist</u></td><td></td><td></td><td></td></tr><tr><td><u>5</u></td><td><u>17</u></td><td><u>Sand, fine - coarse grained unconsolidated, wet</u></td><td></td><td></td><td></td></tr><tr><td></td><td></td><td></td><td></td><td></td><td></td></tr><tr><td></td><td></td><td></td><td></td><td></td><td></td></tr><tr><td></td><td></td><td></td><td></td><td></td><td></td></tr><tr><td></td><td></td><td></td><td></td><td></td><td></td></tr><tr><td></td><td></td><td></td><td></td><td></td><td></td></tr><tr><td></td><td></td><td></td><td></td><td></td><td></td></tr><tr><td></td><td></td><td></td><td></td><td></td><td></td></tr>
7 CONTRACTOR'S OR LANDOWNER'S CERTIFICATION: This water well was (1) constructed, (2) reconstructed, or (3) plugged under my jurisdiction and was completed on (mo/day/year) <u>2/17/98</u> and this record is true to the best of my knowledge and belief. Kansas Water Well Contractor's License No. <u>585</u> This Water Well Record was completed on (mo/day/yr) <u>2/20/98</u> under the business name of <u>ACI</u> by (signature) <u>John J. P. Dean</u>	

INSTRUCTIONS: Use typewriter or ball point pen. PLEASE PRESS FIRMLY and PRINT clearly. Please fill in blanks, underline or circle the correct answers. Send top three copies to Kansas Department of Health and Environment, Bureau of Water, Topeka, Kansas 66620-0001. Telephone: 913-296-5545. Send one to WATER WELL OWNER and retain one for your records.

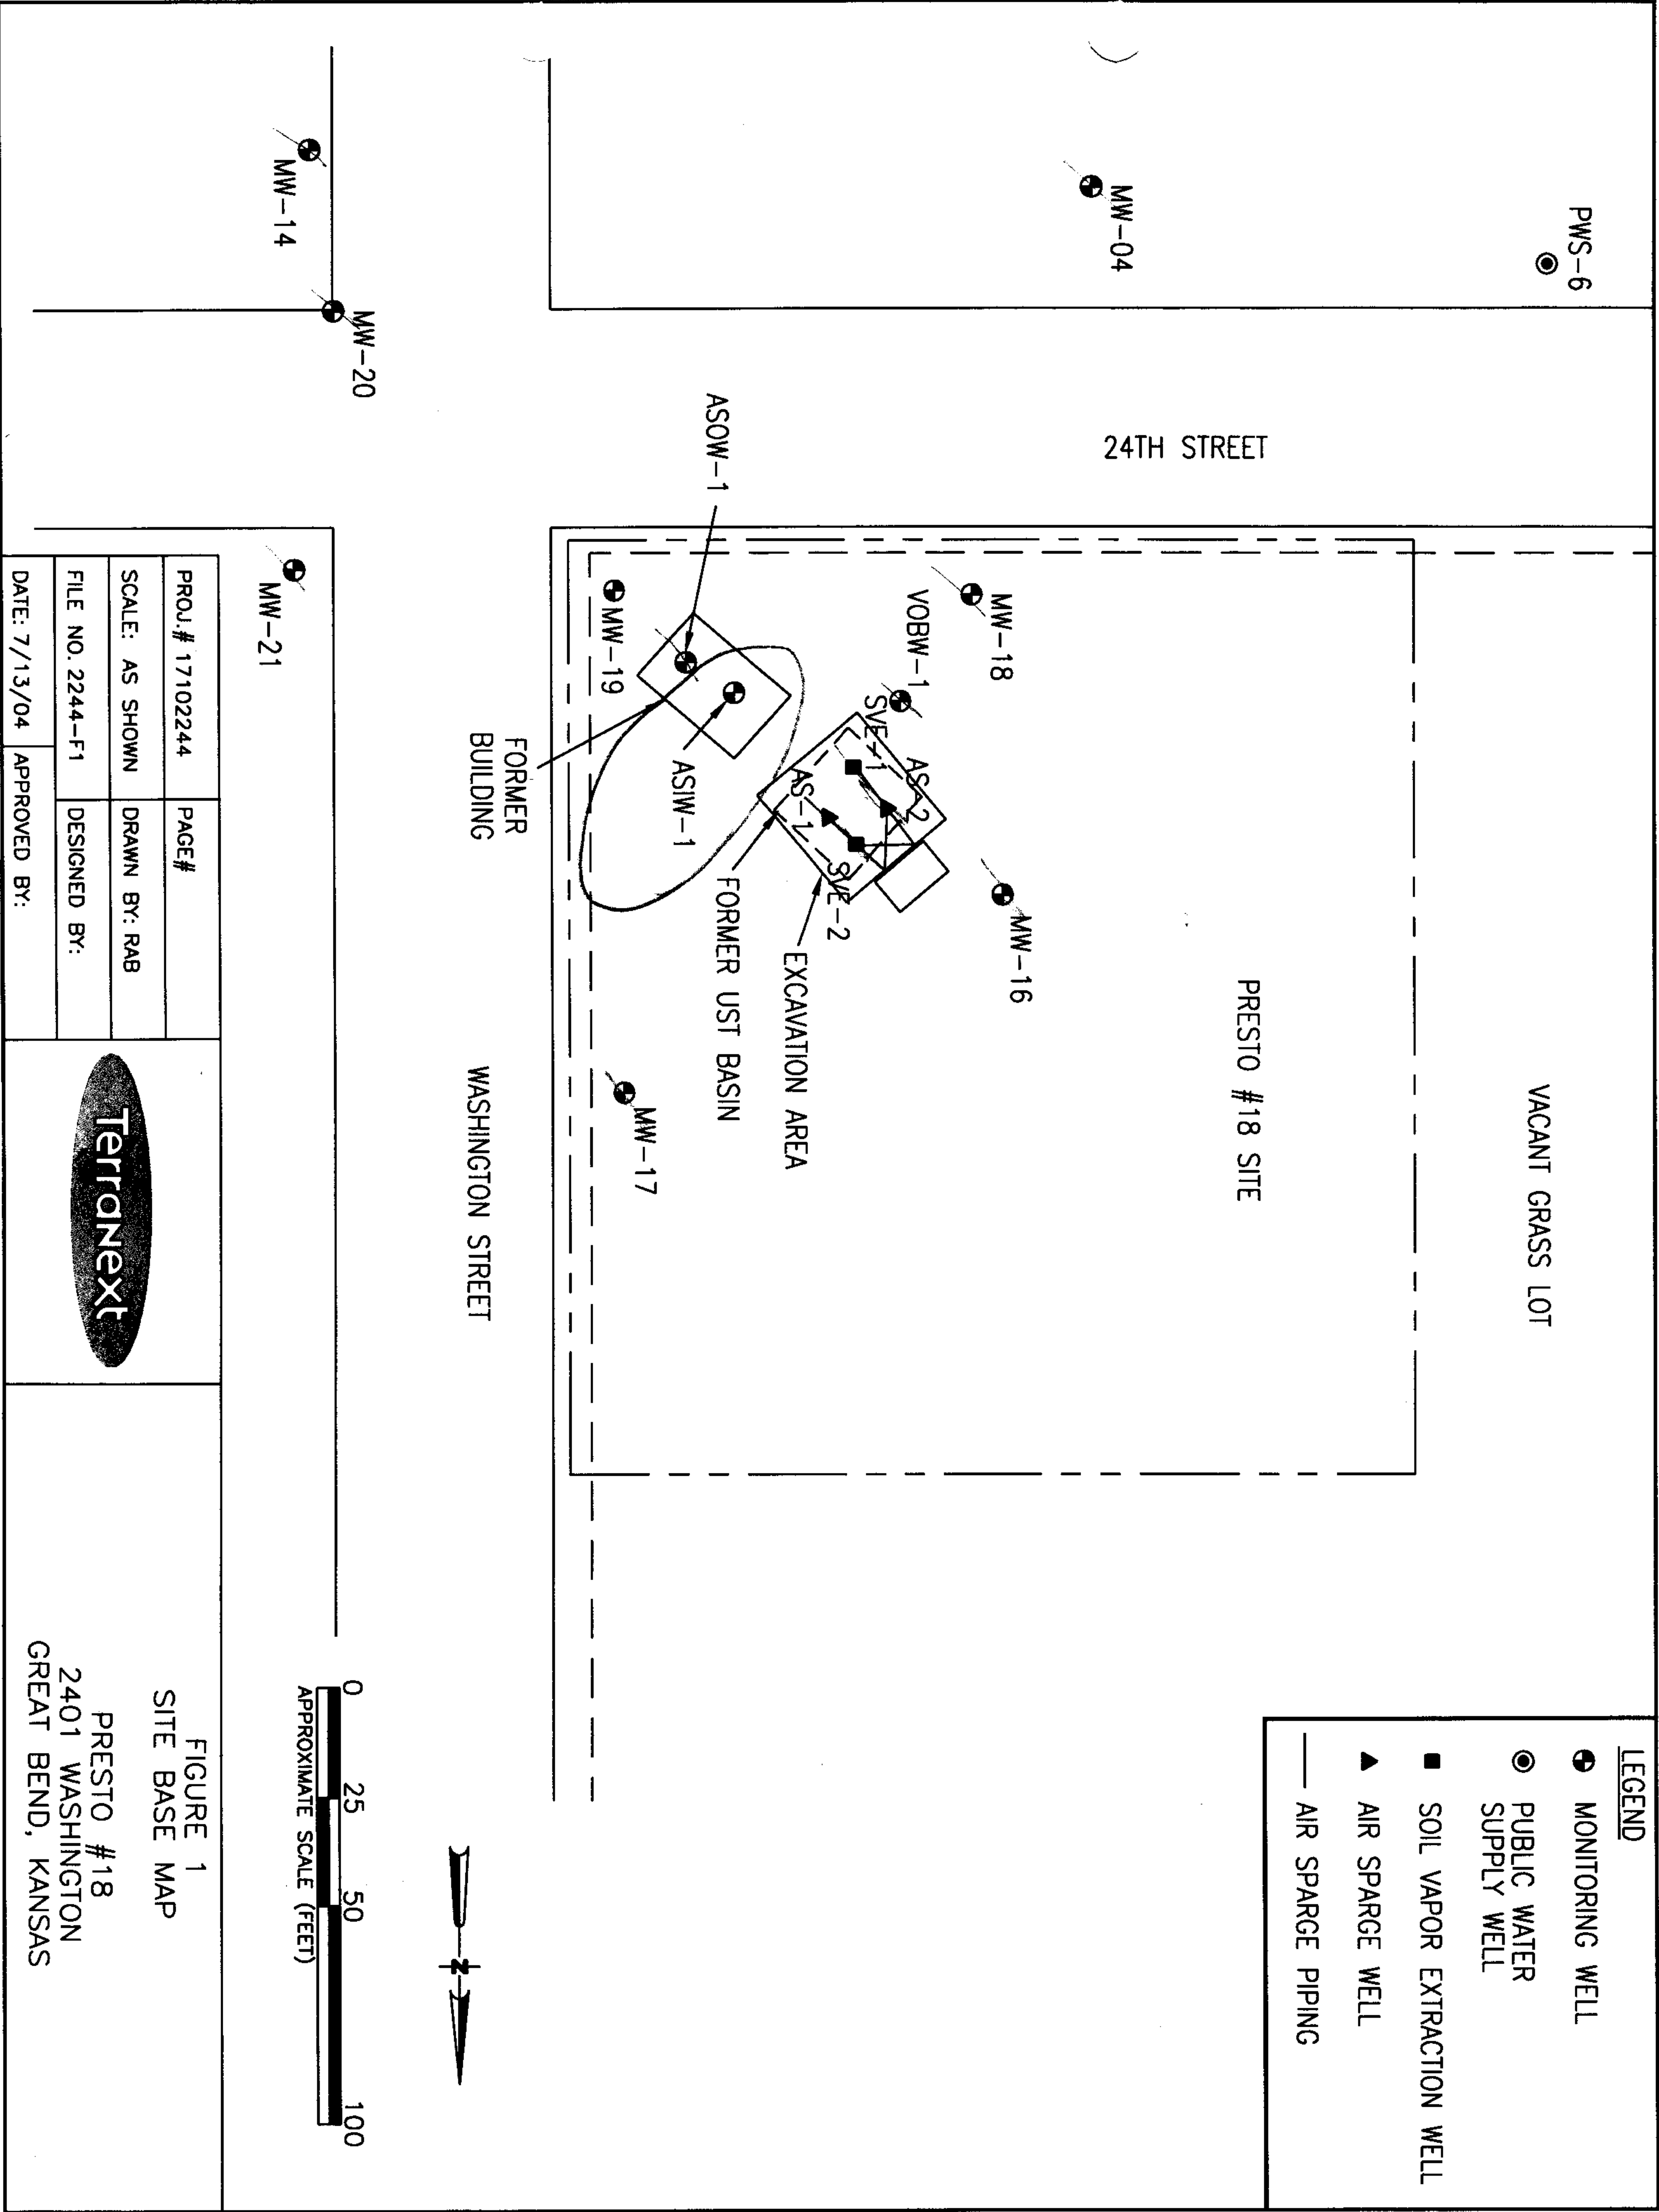

1631 200th Ave.
P.O. Box 1393
Hays, Kansas 67601
(785) 628-3219
(785) 628-2132 Fax
(785) 623-1555 Mobile
E-mail carlson@odsys.net

EVERGREEN ENVIRONMENTAL SERVICES, INC.
10553 Rene
Lenexa, Kansas 66215

March 4, 1998
#8822
page 1 of 1

SURVEYING FOR MONITORING WELLS PRESTO #18, GREAT BEND, BARTON COUNTY, KANSAS

Surveys

Land

Wells were surveyed using the existing control point on site.

Environmental

ALTA

Topography

Architectural

Platting

Construction

Preliminary

Staking

As-builts

Mapping

Site Plans


Utilities

Contours

ADDITIONAL WELLS

#	NORTH	WEST	LATITUDE D M S	LONGITUDE D M S	ELEVATION
MW 15	5405.99	105.91	38-22-37	98-46-27	1852.34 BOLT
SE-SE-SE-SE	103.85				1851.18 TOC
MW 16	5431.39	164.35	38-22-37	98-46-28	1851.67 BOLT
SE-SE-SE-SE	129.25				1851.44 TOC
MW 17	5460.84	43.22	38-22-37	98-46-27	1852.27 BOLT
SE-SE-SE-SE	158.70				1851.77 TOC
MW 18	5356.44	121.21	38-22-36	98-46-28	1851.92 BOLT
SE-SE-SE-SE	54.30				1851.67 TOC
MW 19	5360.95	52.18	38-22-36	98-46-27	1852.16 BOLT
SE-SE-SE-SE	58.81				1851.30 TOC

NOTE: Wells are in Sec 20 T19S R13W.

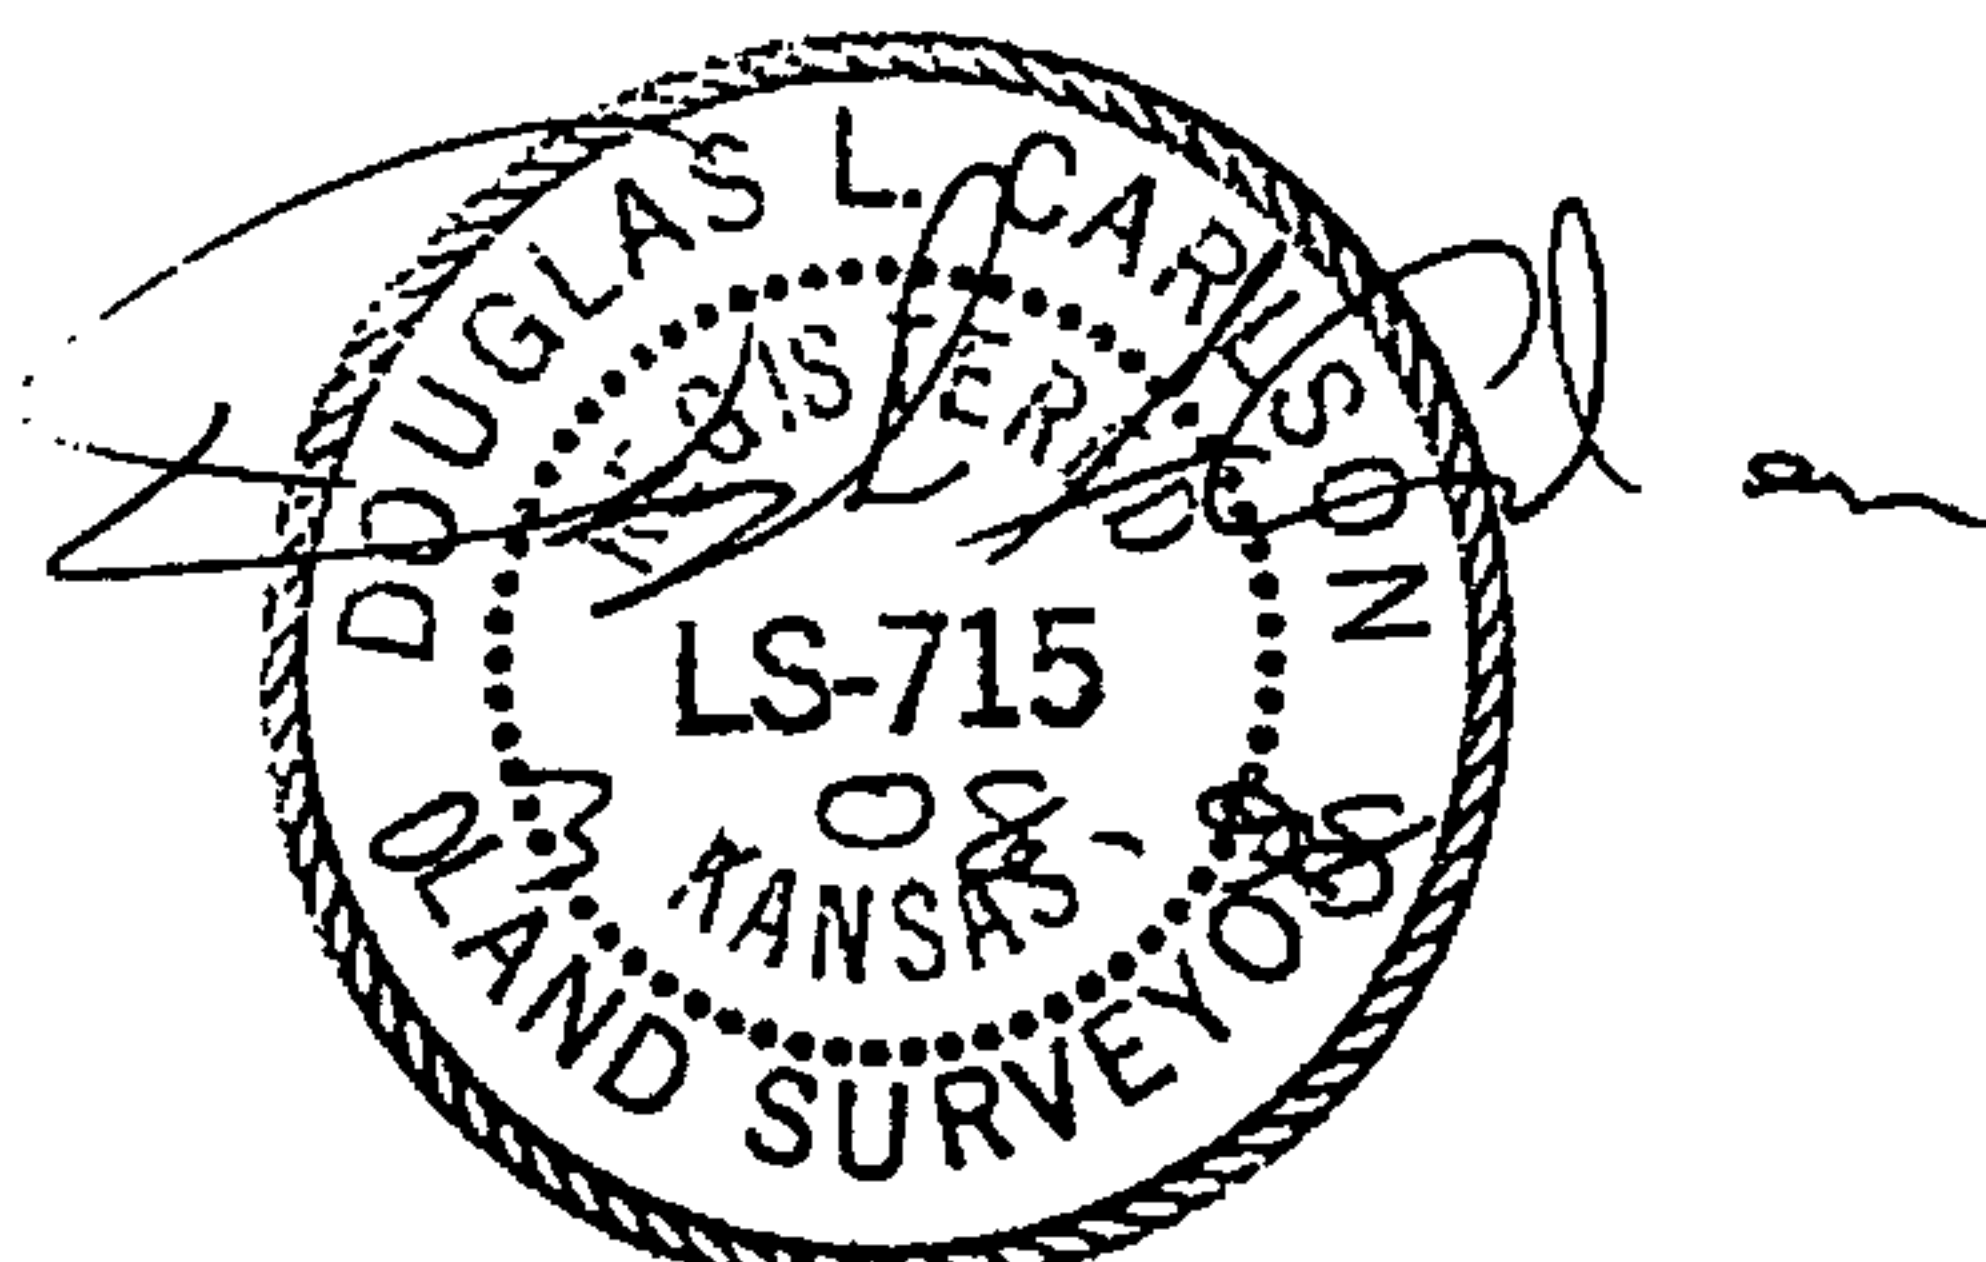

Douglas L. Carlson
Kansas Reg. No. 715