

WATER WELL PLUGGING RECORD Form WWC-5P

KSA 82a-1212

ID NO.

MW9

1 LOCATION OF WATER WELL: Fraction NE 1/4 SE 1/4 NE 1/4 Section Number 33 Township Number T 19 S Range Number 13 ☐ E ☒ W

Street/Rural Address of Well Location; if unknown, distance & direction from nearest town or intersection: If at owner's address, check here ☐ 7TH AND HEIZER, GREAT BEND, KS

Global Positioning Systems (GPS) information:

Latitude: 38.357242 (in decimal degrees)

Longitude: -98.756496 (in decimal degrees)

Elevation: 1842.18

Horizontal Datum: ☐ WGS84, ☐ NAD83, ☐ NAD27


Collection Method:

2 WATER WELL OWNER: KDHE
RR#, St. Address, Box #: 1000 SW JACKSON ST
City, State ZIP Code: TOPEKA, KS 66612

☐ GPS unit (Make/Model: _____)
☐ Digital Map/Photo, ☐ Topographic Map, ☐ Land Survey

Est. Accuracy: ☐ < 3 m, ☐ 3-5 m, ☐ 5-15 m, ☐ > 15 m

3 MARK WELL'S LOCATION WITH AN "X" IN SECTION BOX:

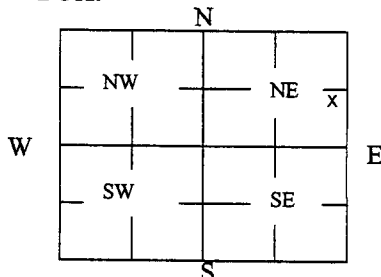

4 DEPTH OF WELL 14.53 ft.

WELL'S STATIC WATER LEVEL 9.44 ft

WELL WAS USED AS:

☐ Domestic ☐ Public Water Supply ☐ Dewatering
☐ Irrigation ☐ Oil Field Water Supply ☒ Monitoring
☐ Feedlot ☐ Domestic (Lawn & Garden) ☐ Injection Well
☐ Industrial ☐ Air Conditioning ☐ Other _____

Was a chemical/bacteriological sample submitted to Department? Yes ☐ No ☒

5 TYPE OF BLANK CASING USED:

☐ Steel ☐ RMP (SR) ☐ Wrought ☐ Fiberglass ☐ Other (Specify below)
☒ PVC ☐ ABS ☐ Asbestos-Cement ☐ Concrete Tile

Blank casing diameter 2 in. Was casing pulled? Yes ☒ No ☐ If yes, how much 3'
Casing height above or below land surface _____ in.

6 GROUT PLUG MATERIAL: ☐ Neat cement ☐ Cement grout ☒ Bentonite ☐ Other _____

Grout Plug Intervals: From 3 ft. to 14.53 ft., From _____ ft. to _____ ft., From _____ ft. to _____ ft.

What is the nearest source of possible contamination:

☐ Septic tank ☐ Seepage pit ☒ Fuel storage ☐ Other (specify below)
☐ Sewer lines ☐ Pit privy ☐ Fertilizer storage
☐ Watertight sewer lines ☐ Sewage lagoon ☐ Insecticide storage
☐ Lateral lines ☐ Feedyard ☐ Abandoned water well
☐ Cess pool ☐ Livestock pens ☐ Oil well/Gas well

Direction from well? NORTHWEST

How many feet? 80

FROM	TO	PLUGGING MATERIALS	FROM	TO	PLUGGING MATERIALS
0	3	SOIL			
3	14.53	BENTONITE			

7 CONTRACTOR'S OR LANDOWNER'S CERTIFICATION: This water well was plugged under my jurisdiction and was completed on (mo/day/year) 2/6/20 and this record is true to the best of my knowledge and belief. Kansas Water Well Contractor's License No. 585. This Water Well Record was completed on (mo/day/year) 2/25/20 under the business name of ASSOCIATED ENVIRONMENTAL INC by (signature) _____


Send one white copy to Kansas Department of Health & Environment, Geology Section, 1000 SW Jackson Street, Ste. 420, Topeka, KS 66612-1367. Send one copy to WATER WELL OWNER and retain one for your records.
Visit us at <http://www.kdheks.gov/waterwell/index.html> Telephone 785-296-5524.

KSA82a-1212

Revised 1/20/2015

Barton

19-13W-33

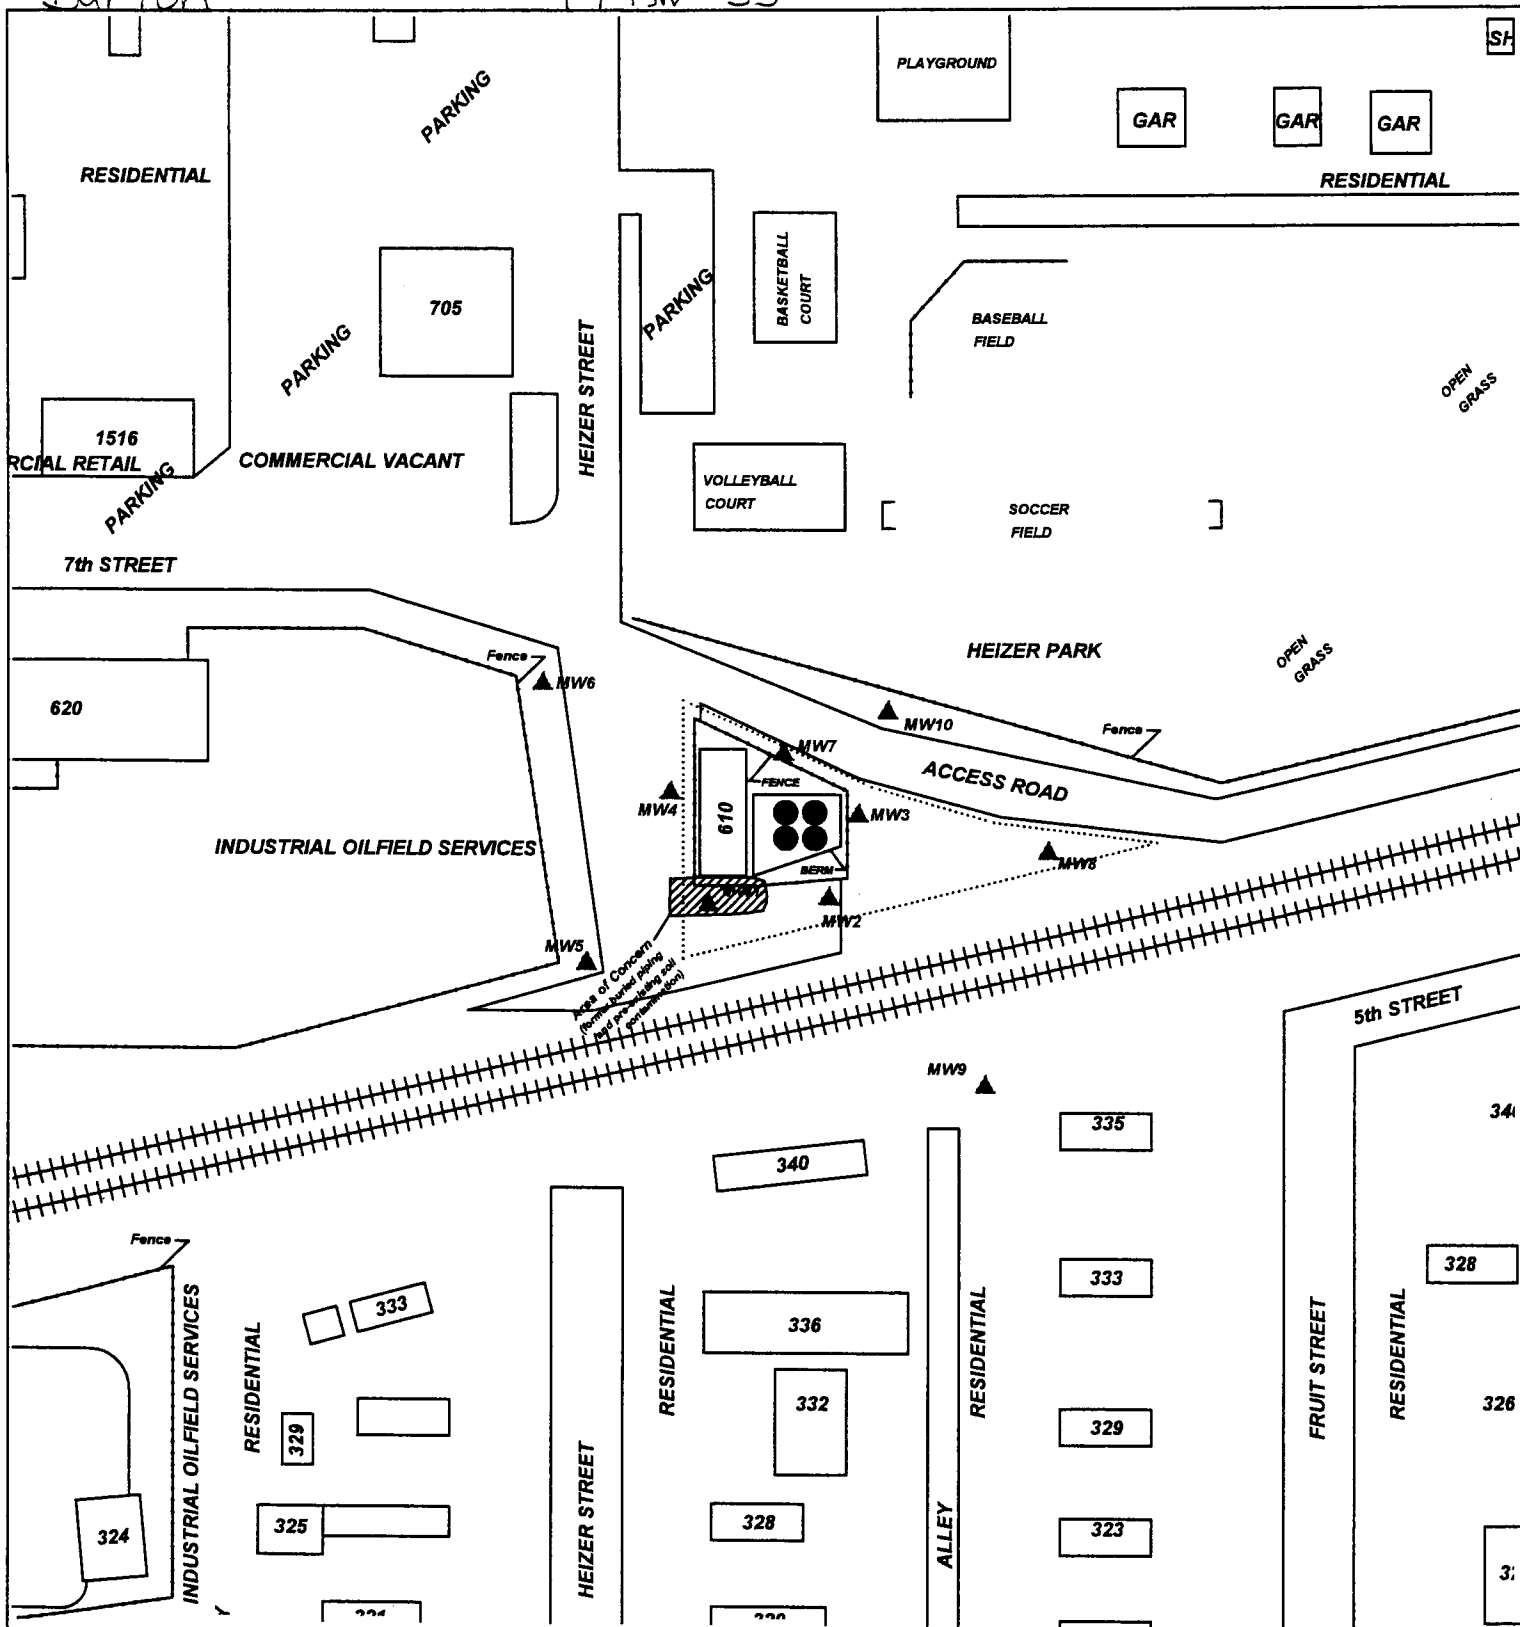

PROJECT: **BIRD OIL BULK PLANT**

ADDRESS: **7TH & HEIZER**

LOCATION: **GREAT BEND, KS**

DRAWN BY: **B. SCOTT** DATE: **12/15/11**

REVISED BY: **B. STALNAKER** DATE: **10/1/19**

AET JOB #: **TM163** KONE JOB #: **A6-005-40325**

TITLE:



**ASSOCIATED
ENVIRONMENTAL
INC.**

LEGEND:

- = 4 - 16,000 gallon ASTs (gasoline)
- = Approximate Area of Excavation (former buried piping and pre-existing soil contamination)
- = Monitor Well Location
- = Plugged Monitor Well Location
- = Site Property Boundary

SCALE: 1" = 100'



0 50 100

NOTES: NO BASEMENTS OBSERVED WITHIN 500'