

# WATER WELL PLUGGING RECORD Form WWC-5P

KSA 82a-1212

ID NO.

MW7

1 LOCATION OF WATER WELL: County: <b>BARTON</b>	Fraction <b>NE 1/4 SE 1/4 NE 1/4 1/4</b>	Section Number <b>33</b>	Township Number <b>T 19 S</b>	Range Number <b>13</b> <input type="checkbox"/> E <input checked="" type="checkbox"/> W
--	---	-----------------------------	----------------------------------	--

Street/Rural Address of Well Location; if unknown, distance & direction from nearest town or intersection: If at owner's address, check here ☐ **7TH AND HEIZER, GREAT BEND, KS**

## Global Positioning Systems (GPS) information:

Latitude: **38.357242** (in decimal degrees)

Longitude: **-98.756496** (in decimal degrees)

Elevation: **1841.88**

Horizontal Datum: ☐ WGS84, ☐ NAD83, ☐ NAD27

Collection Method:


☐ GPS unit (Make/Model: \_\_\_\_\_)

☐ Digital Map/Photo, ☐ Topographic Map, ☐ Land Survey

Est. Accuracy: ☐ < 3 m, ☐ 3-5 m, ☐ 5-15 m, ☐ > 15 m

2 WATER WELL OWNER: **KDHE**  
RR#, St. Address, Box #: **1000 SW JACKSON ST**  
City, State ZIP Code: **TOPEKA, KS 66612**

## 3 MARK WELL'S LOCATION WITH AN "X" IN SECTION BOX:

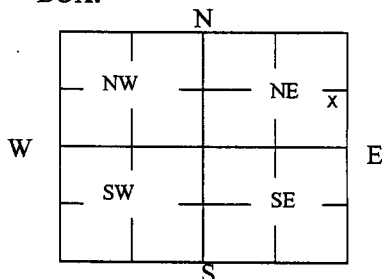

4 DEPTH OF WELL **14.50** ft.

WELL'S STATIC WATER LEVEL **8.92** ft

WELL WAS USED AS:

☐ Domestic  
☐ Irrigation  
☐ Feedlot  
☐ Industrial

☐ Public Water Supply  
☐ Oil Field Water Supply  
☐ Domestic (Lawn & Garden)  
☐ Air Conditioning

☐ Dewatering  
☒ Monitoring  
☐ Injection Well  
☐ Other \_\_\_\_\_

Was a chemical/bacteriological sample submitted to Department? Yes ☐ No ☒

## 5 TYPE OF BLANK CASING USED:

☒ Steel ☐ RMP (SR) ☐ Wrought ☐ Fiberglass ☐ Other (Specify below)  
☒ PVC ☐ ABS ☐ Asbestos-Cement ☐ Concrete Tile

Blank casing diameter **2** in. Was casing pulled? Yes ☒ No ☐ If yes, how much **3'**  
Casing height above or below land surface \_\_\_\_\_ in.

6 GROUT PLUG MATERIAL: ☐ Neat cement ☐ Cement grout ☒ Bentonite ☐ Other \_\_\_\_\_

Grout Plug Intervals: From **3** ft. to **14.50** ft., From \_\_\_\_\_ ft. to \_\_\_\_\_ ft., From \_\_\_\_\_ ft. to \_\_\_\_\_ ft.

What is the nearest source of possible contamination:

☐ Septic tank ☐ Seepage pit ☒ Fuel storage ☐ Other (specify below)  
☐ Sewer lines ☐ Pit privy ☐ Fertilizer storage  
☐ Watertight sewer lines ☐ Sewage lagoon ☐ Insecticide storage  
☐ Lateral lines ☐ Feedyard ☐ Abandoned water well  
☐ Cess pool ☐ Livestock pens ☐ Oil well/Gas well

Direction from well? **SOUTHEAST**  
How many feet? **80**

FROM	TO	PLUGGING MATERIALS	FROM	TO	PLUGGING MATERIALS
0	3	SOIL			
3	14.50	BENTONITE			

**KDHE #**  
**16-005-40325**

7 CONTRACTOR'S OR LANDOWNER'S CERTIFICATION: This water well was plugged under my jurisdiction and was completed on (mo/day/year) **2/6/20** and this record is true to the best of my knowledge and belief. Kansas Water Well Contractor's License No. **585**. This Water Well Record was completed on (mo/day/year) **2/25/20** under the business name of **ASSOCIATED ENVIRONMENTAL INC** by (signature) \_\_\_\_\_

Send one white copy to Kansas Department of Health & Environment, Geology Section, 1000 SW Jackson Street, Ste. 420, Topeka, KS 66612-1367. Send one copy to WATER WELL OWNER and retain one for your records.


Visit us at <http://www.kdheks.gov/waterwell/index.html> Telephone 785-296-5524.

KSA82a-1212

Revised 1/20/2015

Barton

19-13W-33

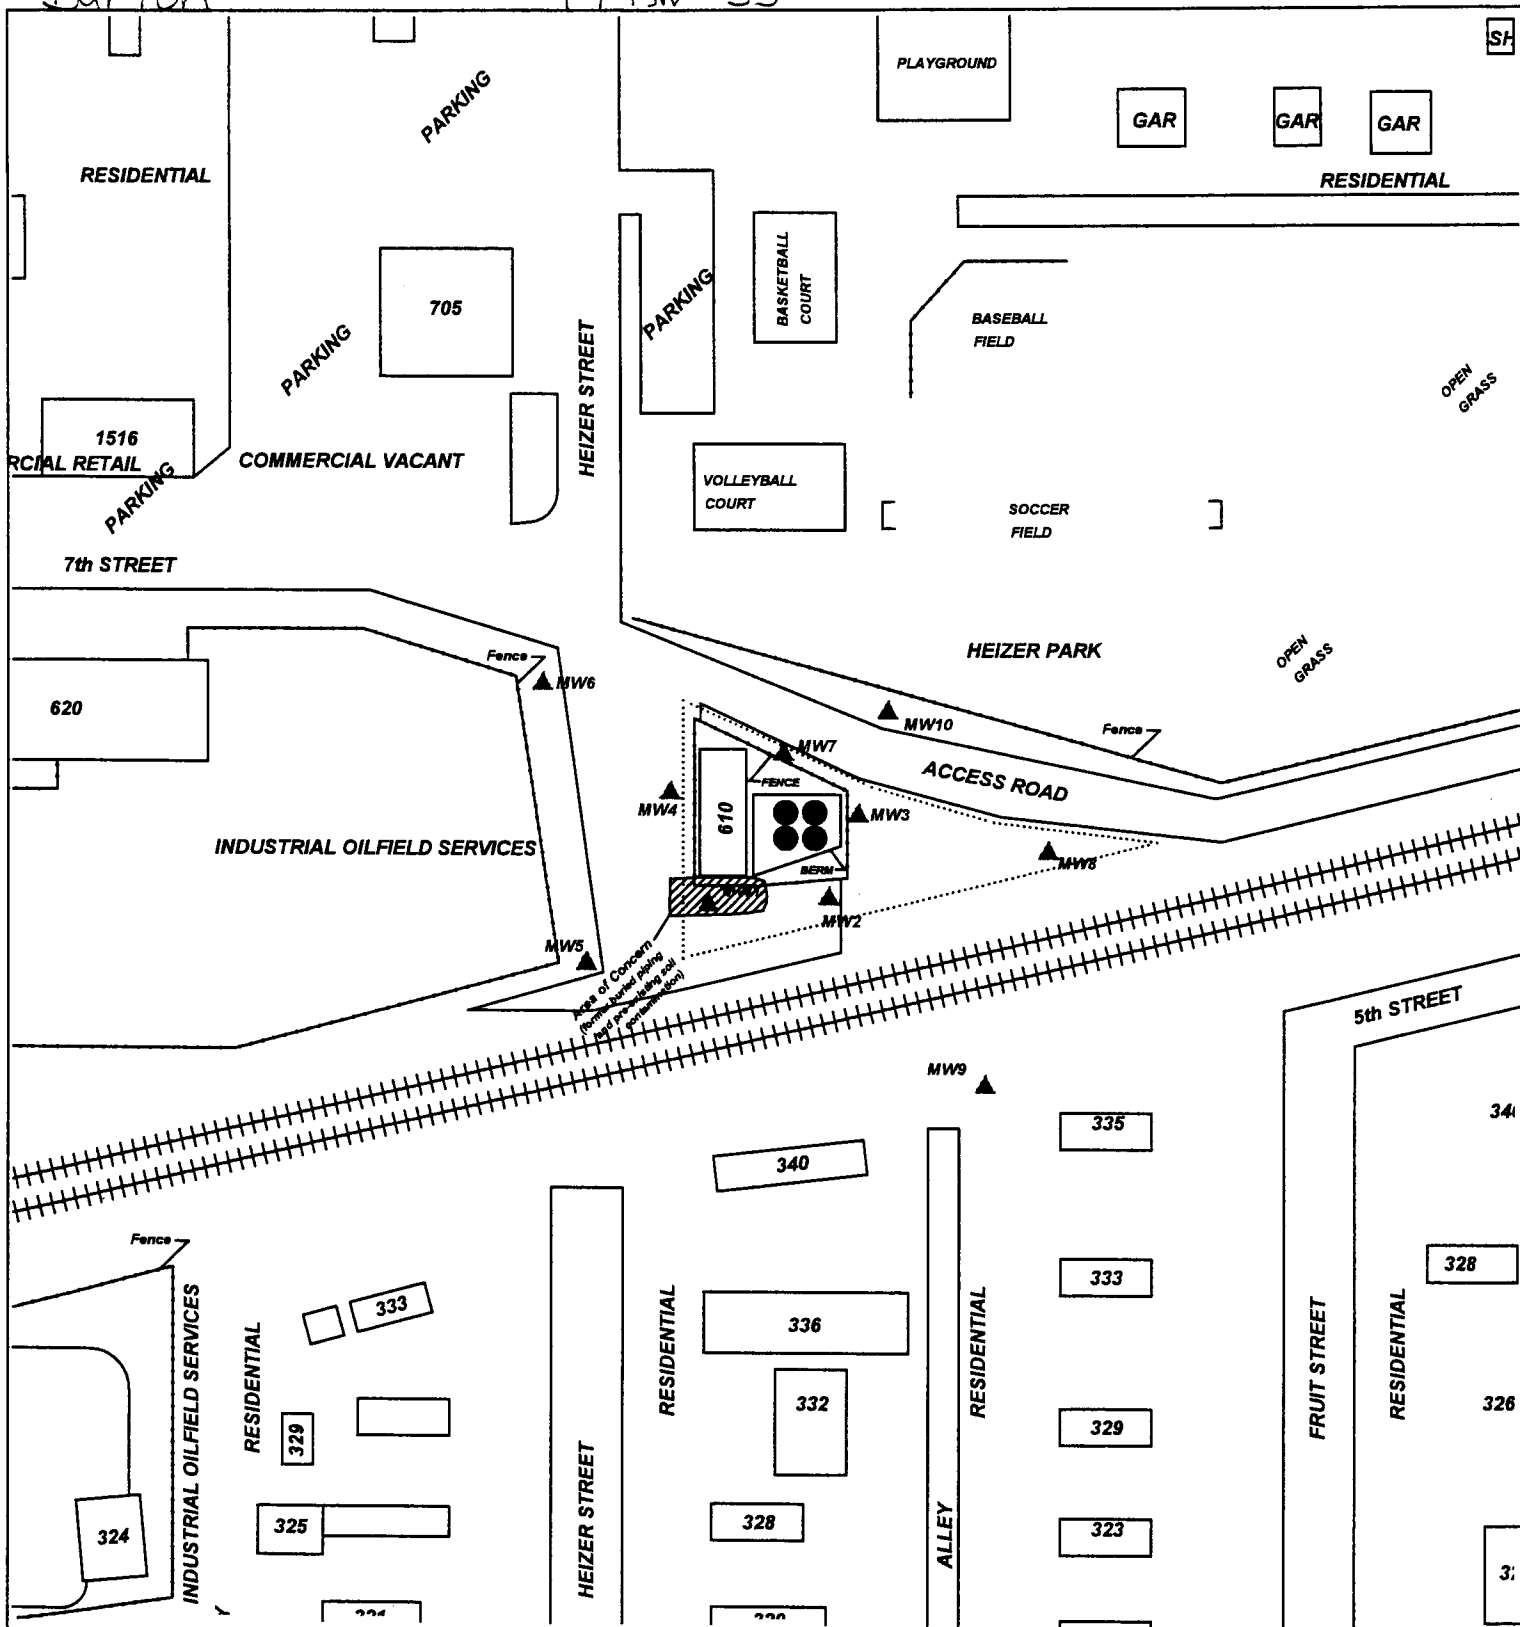

PROJECT: **BIRD OIL BULK PLANT**

ADDRESS: **7TH & HEIZER**

LOCATION: **GREAT BEND, KS**

DRAWN BY: **B. SCOTT** DATE: **12/15/11**

REVISED BY: **B. STALNAKER** DATE: **10/1/19**

AET JOB #: **TM163** KONE JOB #: **A6-005-40325**

TITLE:



**ASSOCIATED  
ENVIRONMENTAL  
INC.**

## LEGEND:

- = 4 - 16,000 gallon ASTs (gasoline)
- = Approximate Area of Excavation (former buried piping and pre-existing soil contamination)
- = Monitor Well Location
- = Plugged Monitor Well Location
- = Site Property Boundary

SCALE: 1" = 100'



0 50 100

NOTES: NO BASEMENTS OBSERVED WITHIN 500'