

WATER WELL PLUGGING RECORD Form WWC-5P

KSA 82a-1212

ID NO.

MW8

1 LOCATION OF WATER WELL: County: BARTON	Fraction NE ¼ SE ¼ NE ¼ ¼	Section Number 33	Township Number T 19 S	Range Number 13 <input type="checkbox"/> E <input checked="" type="checkbox"/> W
---	-------------------------------------	-----------------------------	----------------------------------	--


Street/Rural Address of Well Location; if unknown, distance & direction from nearest town or intersection: If at owner's address, check here ☐ **7TH AND HEIZER, GREAT BEND, KS**

Global Positioning Systems (GPS) information:Latitude: **38.357242** (in decimal degrees)Longitude: **-98.756496** (in decimal degrees)Elevation: **1842.22**Horizontal Datum: ☐ WGS84, ☐ NAD83, ☐ NAD27

Collection Method:

2 WATER WELL OWNER: KDHE
RR#, St. Address, Box #: **1000 SW JACKSON ST**
City, State ZIP Code: **TOPEKA, KS 66612**

☐ GPS unit (Make/Model: _____)
☐ Digital Map/Photo, ☐ Topographic Map, ☐ Land Survey

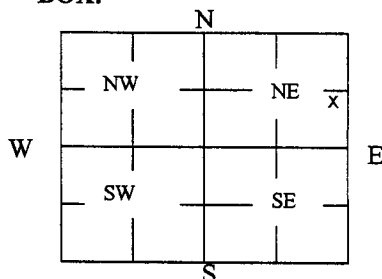Est. Accuracy: ☐ < 3 m, ☐ 3-5 m, ☐ 5-15 m, ☐ > 15 m**3 MARK WELL'S LOCATION WITH AN "X" IN SECTION BOX:****4 DEPTH OF WELL** 15.00 ft.WELL'S STATIC WATER LEVEL 9.54 ft

WELL WAS USED AS:

☐ Domestic
☐ Irrigation
☐ Feedlot
☐ Industrial

☐ Public Water Supply
☐ Oil Field Water Supply
☐ Domestic (Lawn & Garden)
☐ Air Conditioning

☐ Dewatering
☒ Monitoring
☐ Injection Well
☐ Other _____

Was a chemical/bacteriological sample submitted to Department? Yes ☐ No ☒**5 TYPE OF BLANK CASING USED:**

☒ Steel ☐ RMP (SR) ☐ Wrought ☐ Fiberglass ☐ Other (Specify below)
☒ PVC ☐ ABS ☐ Asbestos-Cement ☐ Concrete Tile

Blank casing diameter 2 in. Was casing pulled? Yes ☒ No ☐ If yes, how much 3'
Casing height above or below land surface _____ in.

6 GROUT PLUG MATERIAL: ☐ Neat cement ☐ Cement grout ☒ Bentonite ☐ Other _____

Grout Plug Intervals: From 3 ft. to 15.00 ft., From _____ ft. to _____ ft., From _____ ft. to _____ ft.

What is the nearest source of possible contamination:

☐ Septic tank ☐ Seepage pit ☒ Fuel storage ☐ Other (specify below)
☐ Sewer lines ☐ Pit privy ☐ Fertilizer storage
☐ Watertight sewer lines ☐ Sewage lagoon ☐ Insecticide storage
☐ Lateral lines ☐ Feedyard ☐ Abandoned water well
☐ Cess pool ☐ Livestock pens ☐ Oil well/Gas well

Direction from well? WESTHow many feet? 80

FROM	TO	PLUGGING MATERIALS	FROM	TO	PLUGGING MATERIALS
0	3	SOIL			
3	15.00	BENTONITE			
					KDHE
					16-005-40325

7 CONTRACTOR'S OR LANDOWNER'S CERTIFICATION: This water well was plugged under my jurisdiction and was completed on (mo/day/year) 2/6/20 and this record is true to the best of my knowledge and belief. Kansas Water Well Contractor's License No. 585. This Water Well Record was completed on (mo/day/year) 2/25/20 under the business name of ASSOCIATED ENVIRONMENTAL INC by (signature) _____

Send one white copy to Kansas Department of Health & Environment, Geology Section, 1000 SW Jackson Street, Ste. 420, Topeka, KS 66612-1367. Send one copy to WATER WELL OWNER and retain one for your records.


Visit us at <http://www.kdheks.gov/waterwell/index.html> Telephone 785-296-5524.

KSA82a-1212

Revised 1/20/2015

Barton

19-13W-33

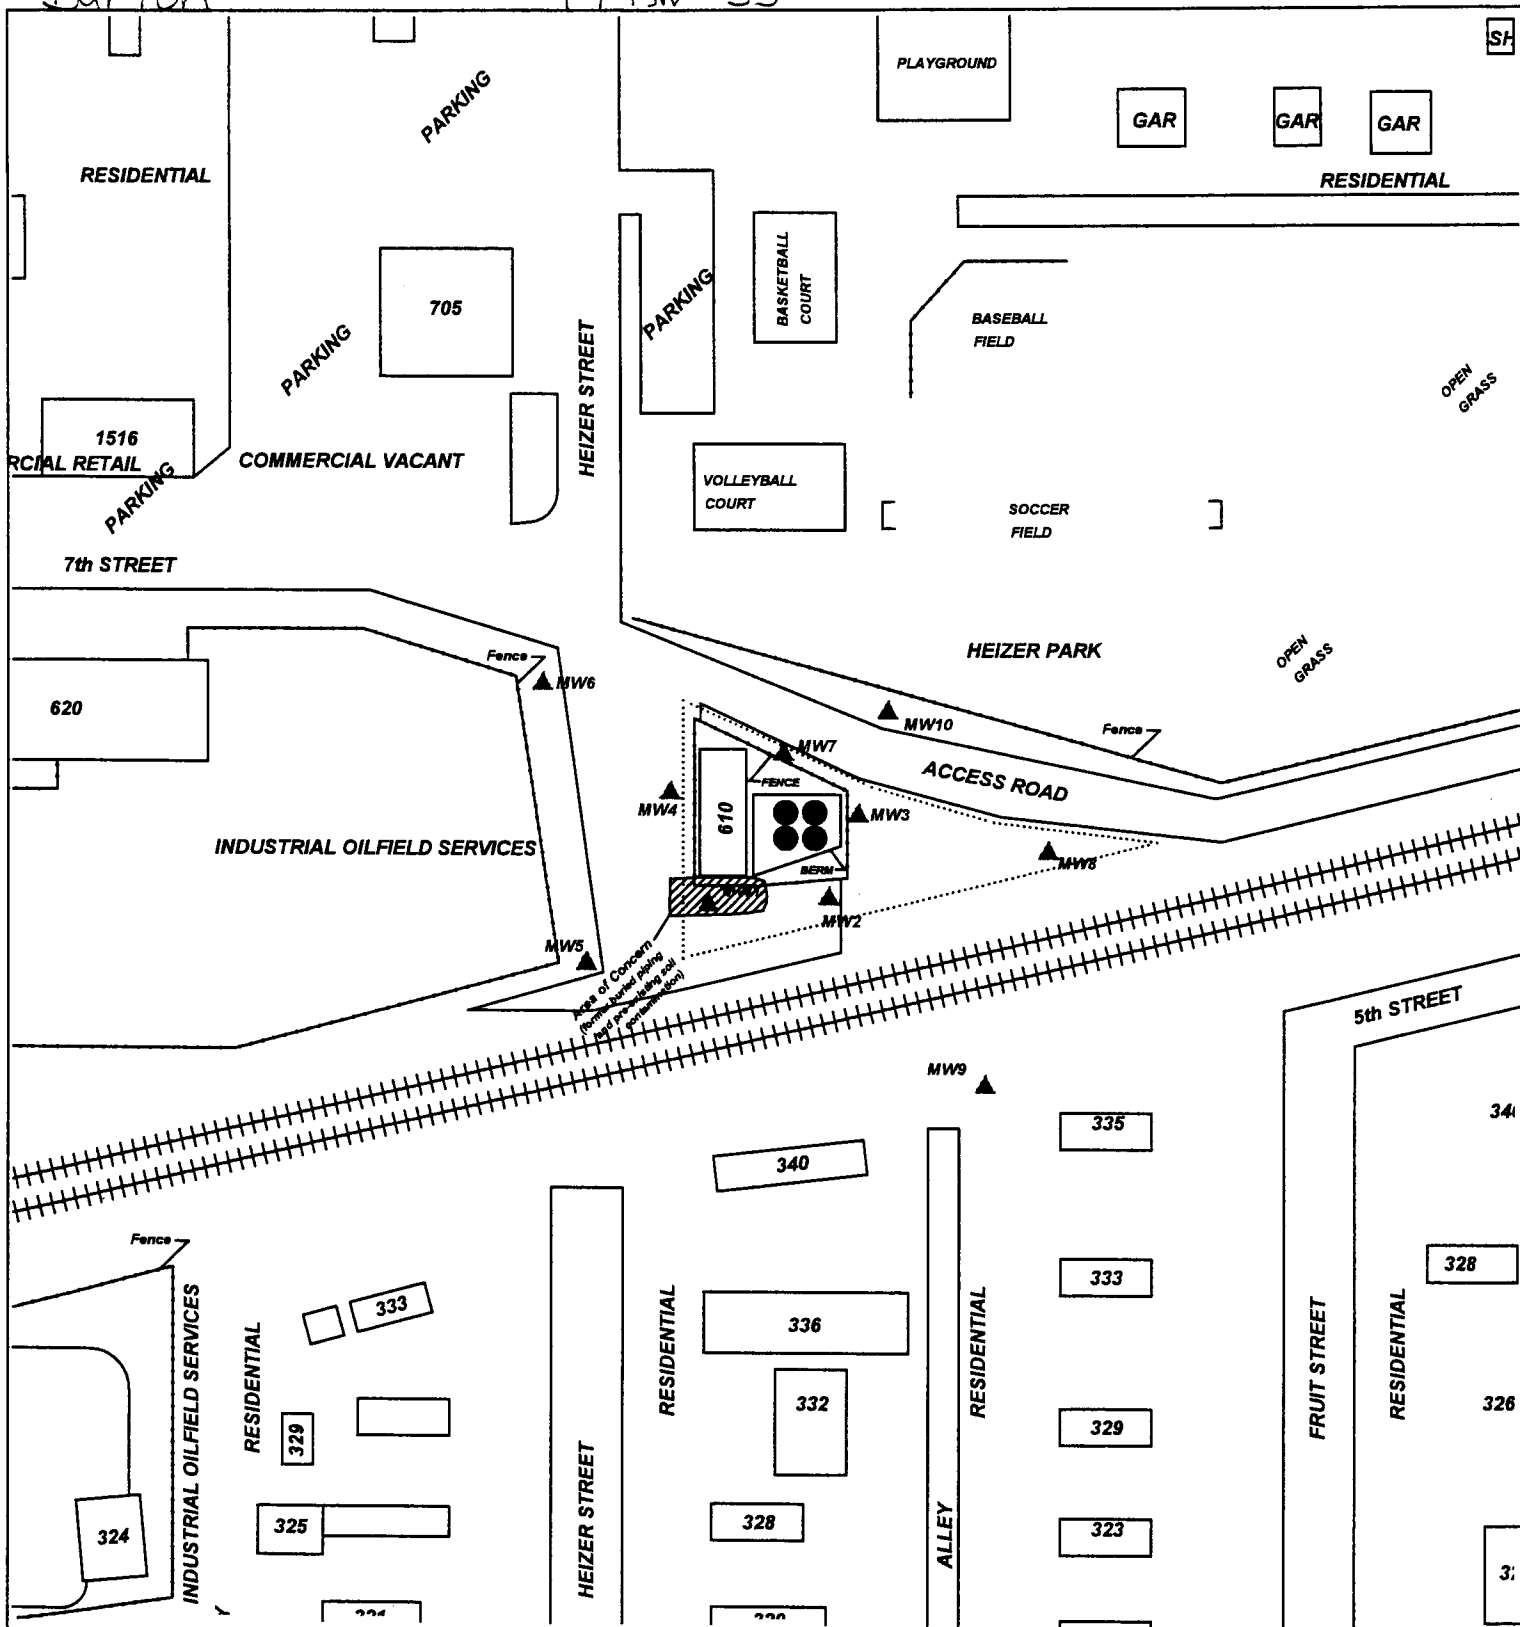

PROJECT: BIRD OIL BULK PLANT

ADDRESS: 7TH & HEIZER

LOCATION: GREAT BEND, KS

DRAWN BY: B. SCOTT **DATE:** 12/15/11

REVISED BY: B. STALNAKER **DATE:** 10/1/19

AEI JOB #: TM163 **KOHE JOB #:** A6-005-40325

TITLE:



**ASSOCIATED
ENVIRONMENTAL
INC.**

LEGEND:

- = 4 - 16,000 gallon ASTs (gasoline)
- = Approximate Area of Excavation (former buried piping and pre-existing soil contamination)
- = Monitor Well Location
- = Plugged Monitor Well Location
- = Site Property Boundary

SCALE: 1" = 100'



0 50 100

NOTES: NO BASEMENTS OBSERVED WITHIN 500'