


☒ Original Record    ☐ Correction    ☐ Change in Well Use

Well ID

**MV4**

[illegible]

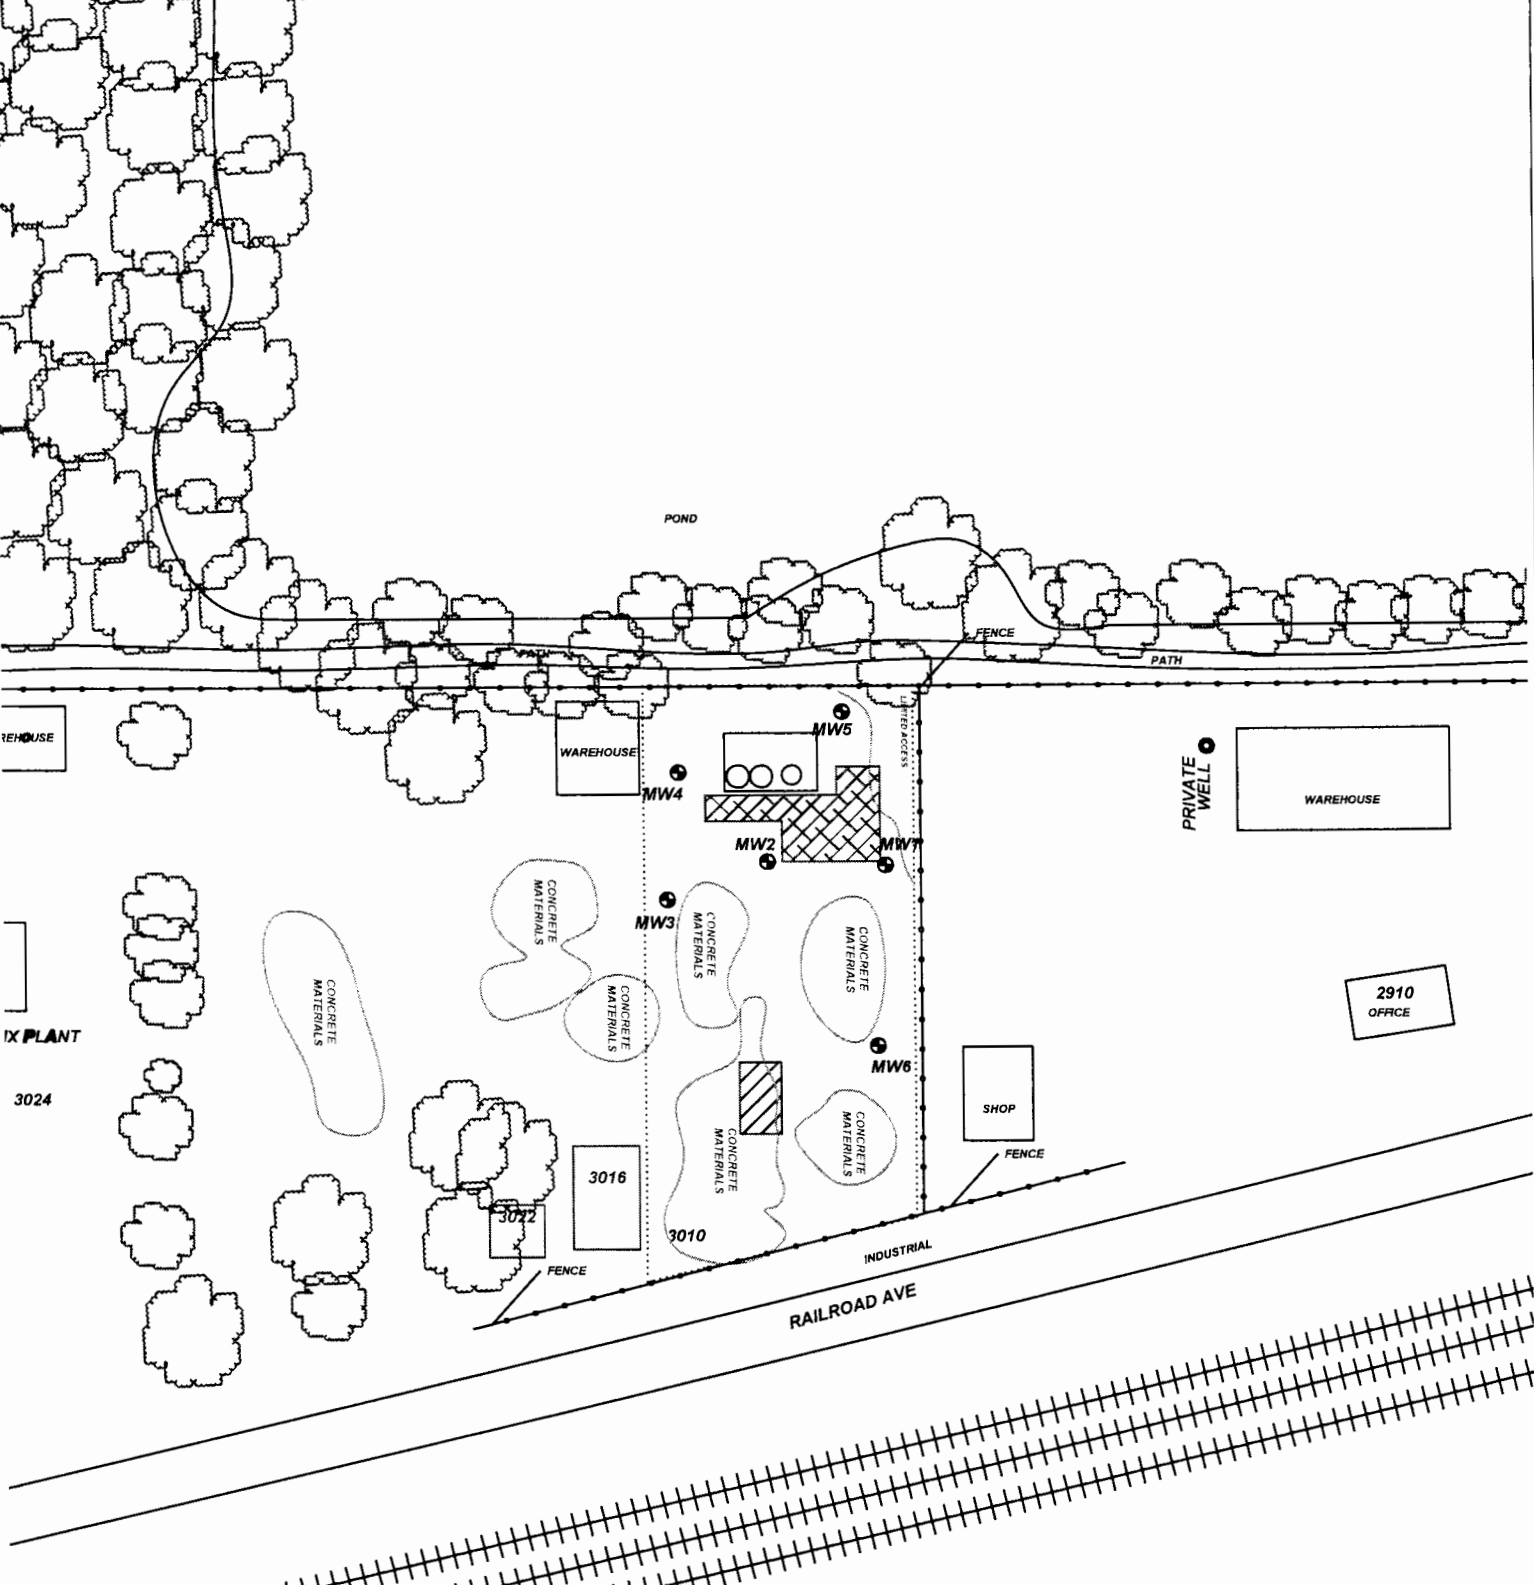

<b>PROJECT:</b> EARL WESTHOFF (FORMER AMES OIL)		<b>TITLE:</b> <b>FIGURE 2.1</b> <b>AREA BASE MAP</b> <b>350' RADIUS</b>	<b>LEGEND:</b> 
<b>ADDRESS:</b> 3010 RAILROAD AVE			
<b>LOCATION:</b> GREAT BEND, KS		<b>ASSOCIATED ENVIRONMENTAL INC.</b>	
<b>DRAWN BY:</b> C. ROE	<b>DATE:</b> 5/14/18		
<b>REVISED BY:</b> C. ROE	<b>DATE:</b> 4/1/22		
<b>AEI JOB #:</b> TM236	<b>KDHE JOB #:</b> A6-005-40222		
<b>SCALE:</b> 1" = 100' 		<b>NOTES:</b> *INDICATED BORING FOR UNSATURATED HYDROLOGIC ZONE SAMPLE	